


## STATE OF INDIANA STATE HIGHWAY DEP RTMENT

## PLAN AND PROFILE OF PROPOSED STATE HIGHWAY U.I. PROJECT NO. 265 (17) TRI - STATE HIGHWAY R/W BEGINNING AT A POINT APPROXIMATELY 959.5 FL.WEST OF THE EAST LINE OF SEC. 17,

BEGINNING AT A POINT APPROXIMATELY 959.5 F. WEST OF THE EAST LINE OF SEC. 17, T-3G-N-, R-9-W, AND RUNNING IN AN EASTERLY DIRECTION TO A POINT 790 F. WEST OF THE EAST LINE OF SEC. 16, F3G-N, R-9-W, ALL IN LAKE CO.

> GROSS LENGTH:- 1.041 MI. NET LENGTH:- 0.999 MI. SCALES:-PLAN  $\begin{bmatrix} LONG:- 1''=100' \& 1''= 50' \\ TRANS:-1''=100' \& 1''= 50' \\ TRANS:-1''=100' \& 1''= 50' \\ \end{bmatrix}$  HORIZ:-1''=100' & 1''= 50' VERT:- 1''=10'

MAX. GRADE 3,00%

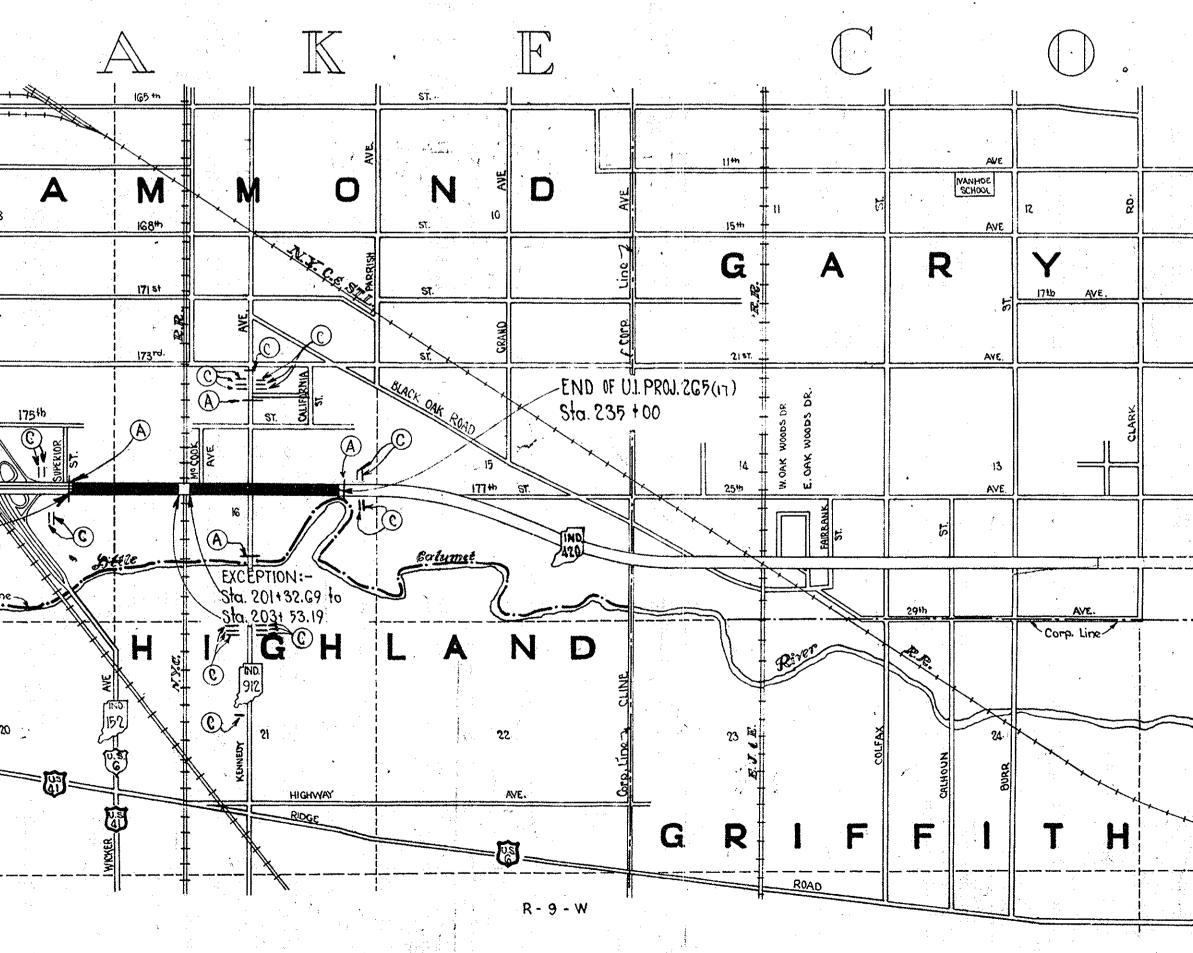


RECOMMENDED FOR APPROVAL 7-6-54

W. H. Rehrens


		FFC DI T	ASION NO. STATE	PROJENO FISCAL YEAR 269(17) 1954 Re Fr	I G5 fucned I-18-6	
				ي ب	$\frac{1-18-6}{1.227}$	6) }.
		$n^{-1}$				
		$ \mathcal{A} $				
	0	$\sim v$ .				
na in the second second						
			and an Argentania An Angel An Angel			
		<b>N</b>				
		••••••••••••••••••••••••••••••••••••••				
		DATE 5-13-54			REVISED R/W	
<b>)</b> -						
			- 			
<b>X</b> - <sup>1</sup> 2 						
:1"= 2000			1 			
-			an a		n - n	ری بر در بار بر در بار بر در بار بر جه بر
2000 - 1999 1990 - 1999 1990 - 1999			APPROVED By State Hid	AND ADOPTE	DOF INDIANA	<u>ط 7</u> م ر
			APPROVED	RMAN - STATE HIGHWAY	DEPARTMENT OF INDIA	NA T
	an an Arabana An Arabana An Arabana	• • • • • • • • • • • • • • • • • • •	C. C	G. Vogel NGINEER - SOTE HIG	gesang	NDIANA
	· · · · · · · · · · · · · · · · · · ·			MENT OF COMME		

APPROVED:-DISTRICT ENGINEER


DATE

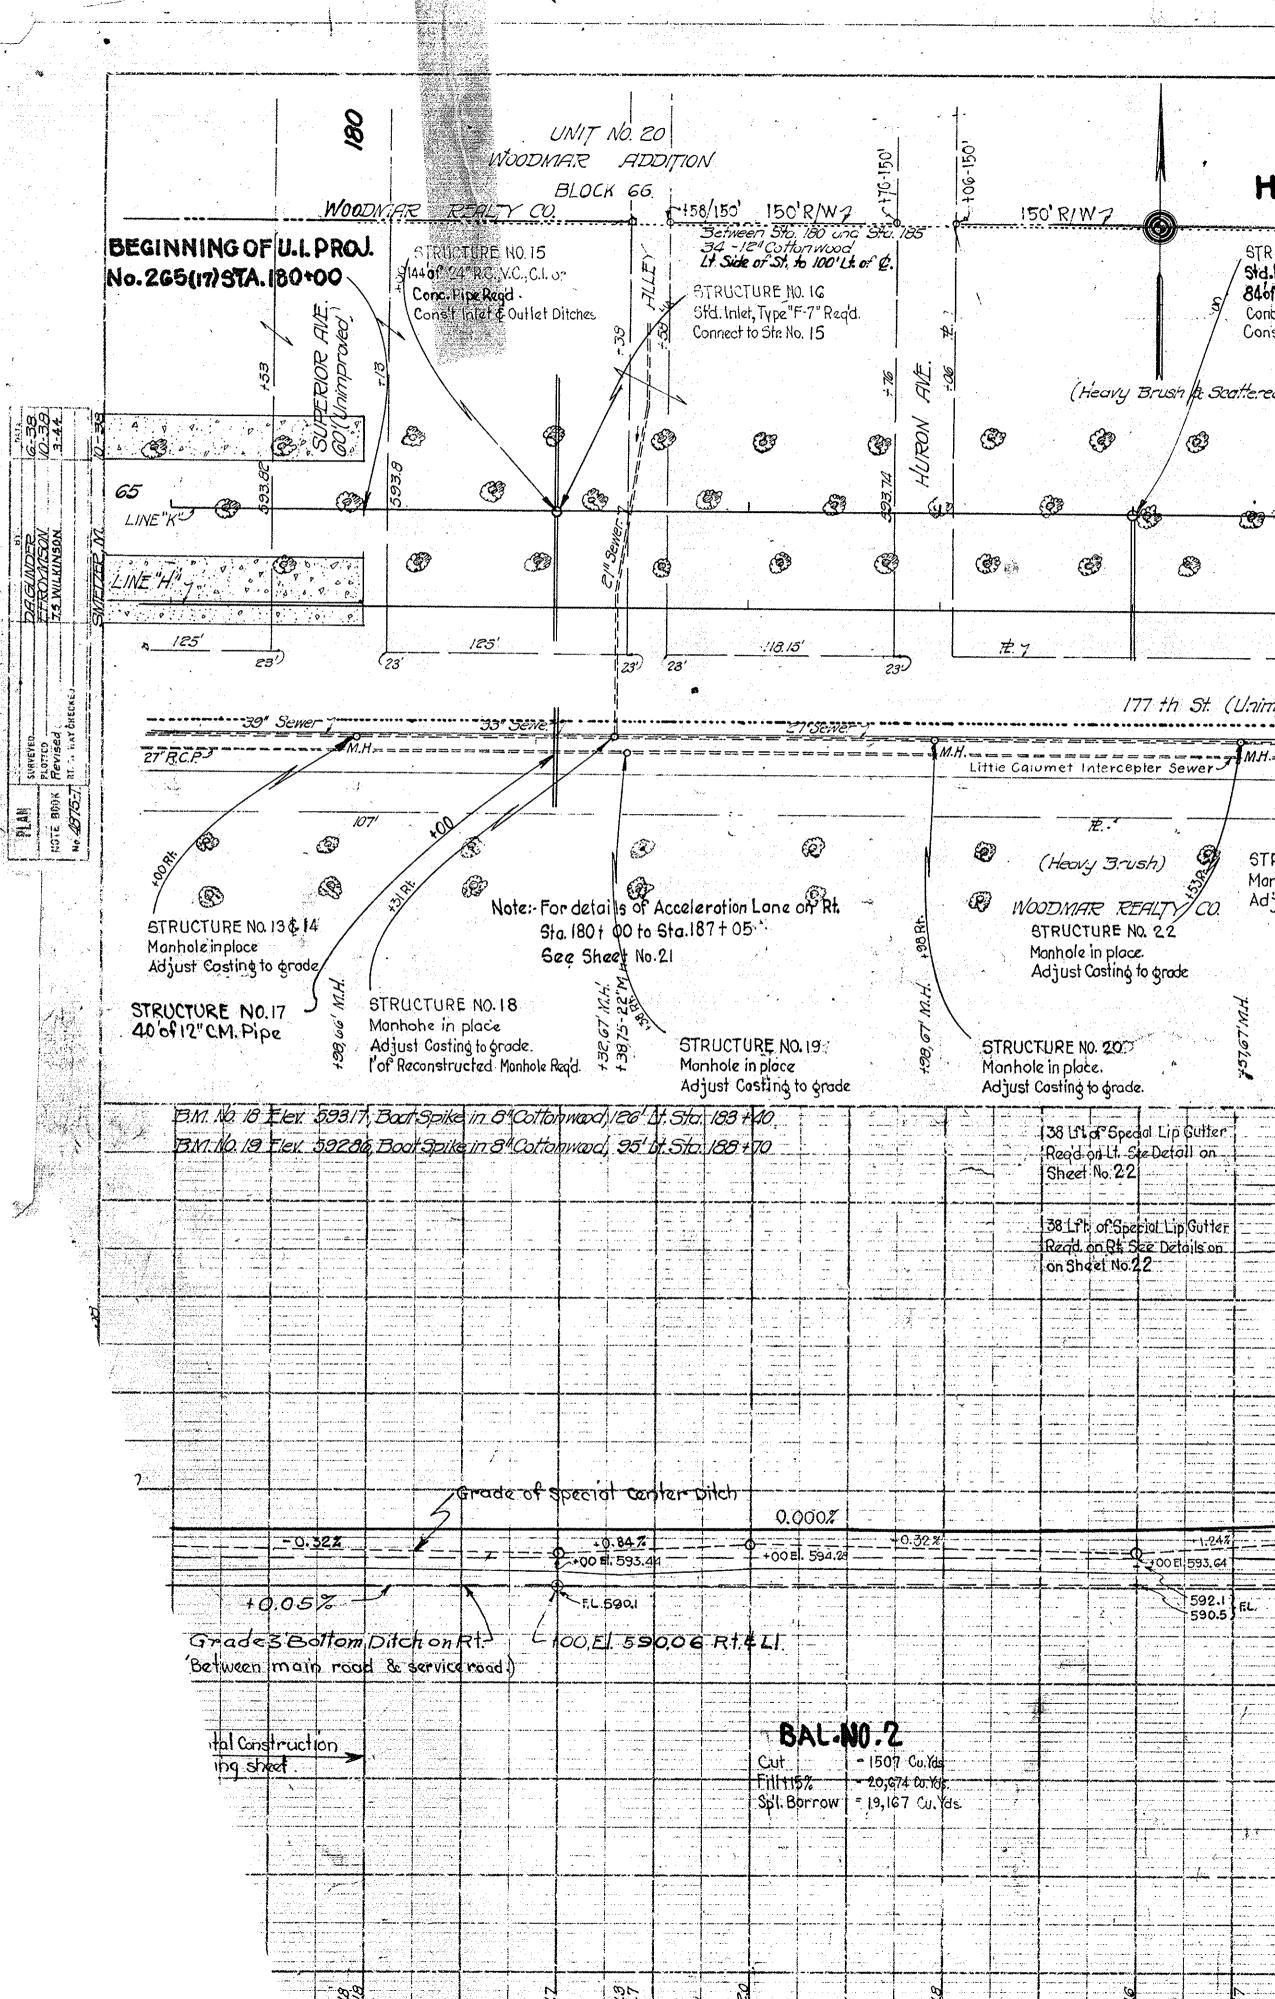

and the second TOTRAL ROAD STATE VII FISCAL SHEET DIVISION NO. STATE PROINO YEAR NO. End of Limited Access Fence Sta. 187+50 STRUCTURE No. 25 St'd. Inlet, Type "D-G" & 48'0° 12" R.C., V.C., C.I. or 1.VD. 265(1) 1954 9 GI 4 SECTION : R/W Rev. Per Road STRUCTURE No. 26 Design Dept. 5/13/54 HAMMOND STRUCTURE NO. 30 & 31 STRUCTURE NO.34 **ETRUCTURE NO.38** Conc. Pipe Regd Std. Inlet Type"F-7" & Stid Inlet Type" D-G"& Std. Inlet Type"D-6" & Std. Inlet Type "D-6" & 48'of 12" R.C., V.C., C.I.or Connect to Str. No. 26 150' R/W 99'of 12" R.C., V.C., C.I. or 48' of 12" R.C., V.C., C.L or 99' of 12" R.C., Y.C., C.I. or HAMMOND TRUST SAVINGS BANK 150' R/W2 Connect to Str. No.39 Conc. Pipe Rego Jonc. Pipe Keqd. Connect to Str. No. 27 STRUCTURE NO.2 Connect to Str. No. 32 Connect to Str. No. 35 Std.Inlet Type"E-7"& 8461º 12"RC. V.C.C.I. or SEC.17-T36N-R9W SEC. 16-736N-R9W SANDOR & FANNIE SINGER ; Between Sta. 185 and Sta. 190 100 - 12" Cotton wood Lt. Side of St. to 100'Lt. of Q. Conc. Pipe Read NORTH TWP. NORTH TWP. Construct Outlet Ditch Setween Sta. 190 and Sta. 195 80 - 12" Cottonwood 11. Side of St. to 100' Lt. of & . LAKE COUNTY LAKE COUNTY NOTE: Minimum R/W On This (Heavy Brush & Scattered Timber) Sheet To Be As Shown. Limited Access R/W(L.A.R/W) To BEAS Showing (Heavy Brush & Scottered Timber) 183 183 (C) æ, CLINE "K" TO BE CONSTRUCTED POT 189+56.5 Ê CLIN#"K (B) ٢ E) E. S89°-40'E 1 P.O.T. 189456.5-SERVICE ROAD REQ'D ON RT. C2-8" Pipe Line Sincloir Oil Co - Limited Access Fence Location (Grade only to be constructed.) ~ 177 th St. (Unimproved) Approx. 114 ====Sec. Cor. 177 th St. Winimproved ====**M**.H.====== End of Limited Access R/W-7 Fence. Sta. 187750 #+00,PL'-107' RIW STRUCTURE NO. 23 +40,119~ 8 Gasoline Pipe Line Standard Oil Co i (i) STRUCTURE NO. 3 STRUCTURE NO. 35 Manhole in place (Gruss) / STRUCTURE NO.37 Std.Inlet, Type"D-6 & Std. Inlet Type "F-7" & Adjust Costing to grade @ 38' of 12"C.M. Pipe Reg'd. 48' of 12" R.C., V.C., Ct or E. Monhole in place 2-26° Bends Regid. Conc. Pipe Regd. STRUCTURE NO.24 STRUCTURE NO. 27 Adjust Casting to grade LSTRUCTURE NO.33 STRUCTURE NO. 39 Connect to Str. No. 36 St'd. Inlet TypeD - 6" & Manhole in place. 12'Cot. 22 Cot. 34 of 12" C.M. Pipe Regit Stid. Inlet Type "D-6" & 12"Cot. Adjust Casting to grade 24 of 12" C.M. Pipe Regd O STEUCTURE NO. 36 70 of 12" C.M. Pipe Regid. STRUCTURE NO. 29 2-26° Bends Regd. Stid Inlet Type"D-6" & 66.90' 5118 2-26° Bends Reg'd. 23.20 24"Tw. Cot. Manhole in place 56'of 12" C.M. Pipe Regd. 32.25 STRUCTURE NO. 28 Adjust Costing to grade 2-26 Bends Read. R/WON THIS SHEET 95,88 14.25 Manhole in place 150' ON LT. OF LINE "K" PWP S 24"Cot. Adjust Casting to prode Anchor Pole PRESENT R/W ON RT. EXCEN P.J.T. 189+565 (IPL.) POT-189+56.5(W.H.L) 1638Lft+S'd. Lip Gutter Read. on Lt. 1638 Lft Std. Lip Guller-Regd. on Rt. 14.44 51.3 2 PL 596.00 V.C. 1000 سميد سنج بلهجيتها ومن م +13.00 ----615.4 C08.1 607.8 607.2 L1614.9 -(5907 **N** 590.5 . \_600\_\_\_\_ 600.7 600.7 Grade de Service Road on RI par par de la segue 0+00% 9+00% E/ 39300 7 -----------590 592.1 (596.8 | 590.0 | 596.1 10.05% -Gradeon 3'Bottom Ditch on RIELT (Between main road and service road on 591.1 1424 Lin Fil of Guard Rait-Road tartt-(Pay Length = 1444 Lin. Ft.) 1424 Lin.Ft. of Guard Rail Regd on Rt. (Pay Length = 1444 Lin.Ft.) BAL.ND.3 Cut 648 Cu.Yds. Fill+15% = 202,851 Cu.Yds. -Spl. Borrow - 202,203. Cu. Yds. 1 News 

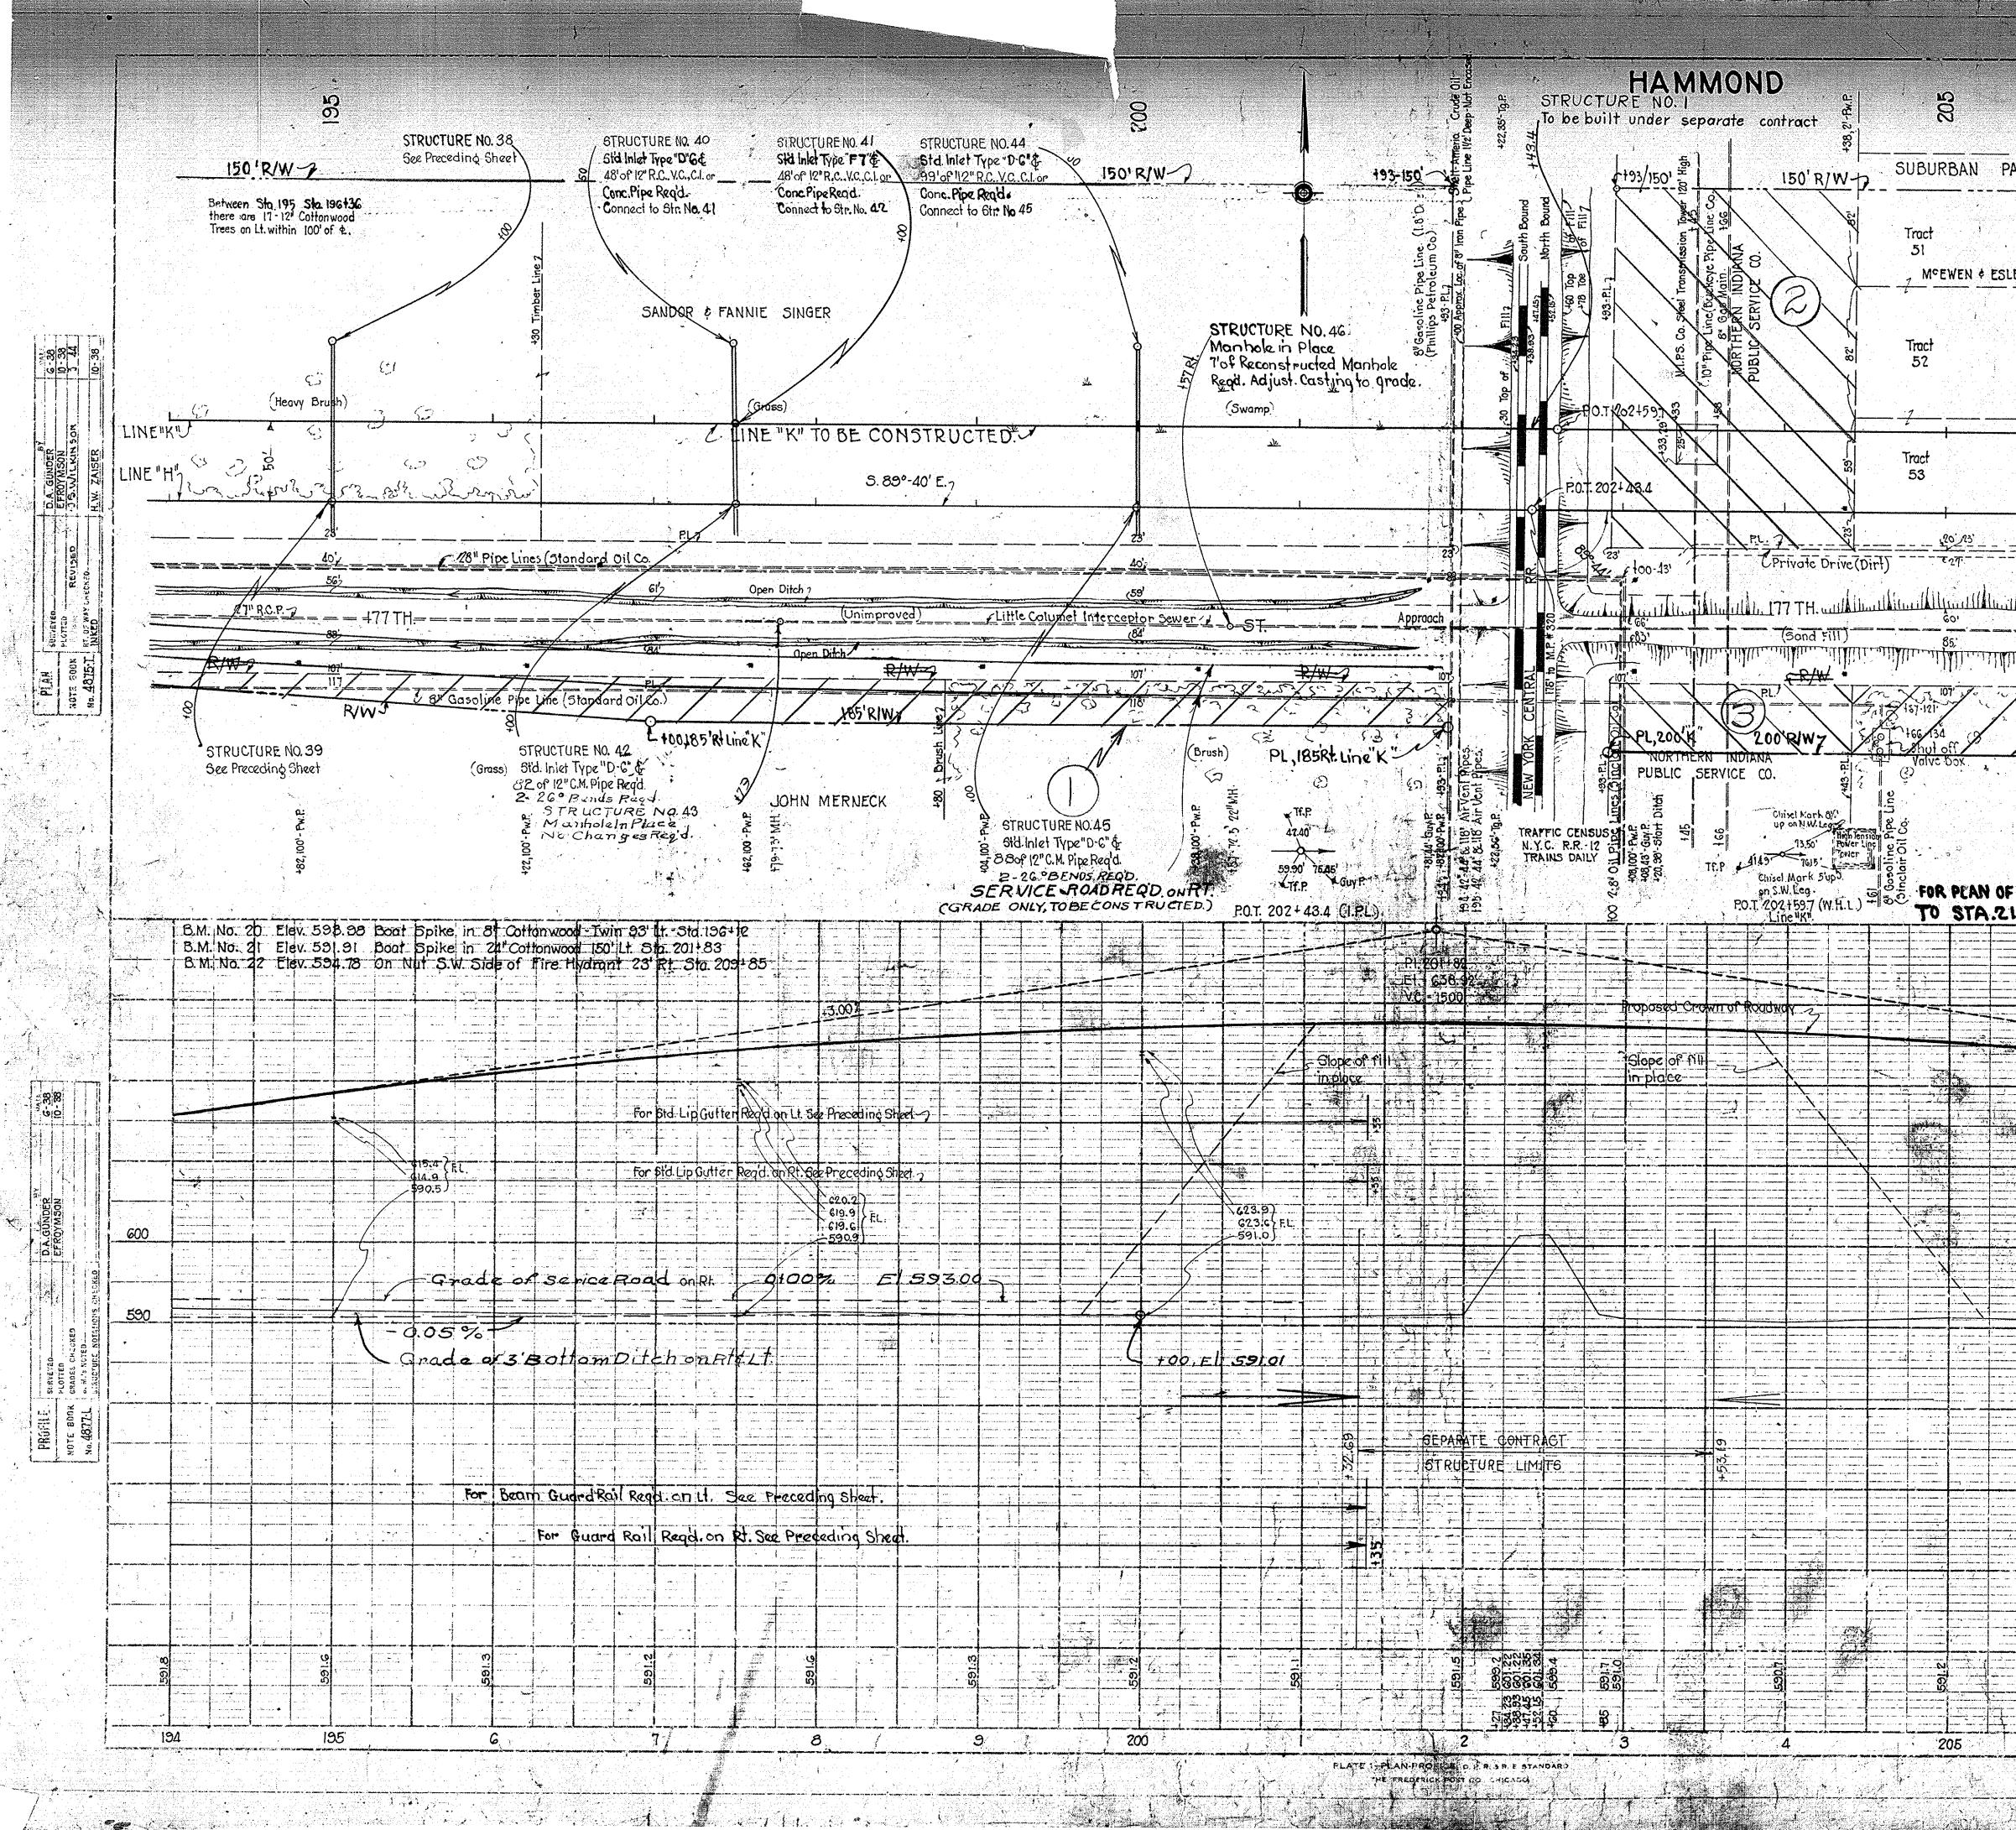

		•	• •			09'-M.H.			8 \	H:W-;60		25 	FE C	DERAL'R IVISION: 1 4 SEC	220000000000000000000000000000000000000	ND. 2 	2.1. F 22.1. F 22.1.0 Y 65(n) ( 1W R.4	(954 2 Y . Pe	10, zr Ri	bad
<u> </u>	+00-15	0'8		۲ ۲	· · · ·	1	<u>C150'</u>	- I :	+86-1	>~			<u> </u>	) <u>' R/W</u>	; Ę	€ ++31			. 9~1 Q= 8	3-54
IN	<b>C.</b>			L			<u>126.3</u>	11́М ТК 8'	10 5 	-14   -17		23 - <u>1</u> 22	JOHN 1 <u>126.3</u> 8	WILH	ELM TR	9	AVE.	• • • •	<b>6</b>	
		+00 FL.1			102'	MH	12*V.P.7	<u>PL7</u> 20'1	ALLEY		8 1H	<u>12" V.P</u>			6"V.P.7 UE	122 102 102		woter Moin	22' S 102'	
					3	2 8	13 क		15 <del>- 1</del> 5		<b>-</b>	10 <del>4</del>	19 🗐	20 <u>s</u>		1323 RL	LEXANDER	14-261	<u> </u>	۱ <b>۲</b> , ۱۳
							ן א נ	) н N		w 1		: L M		F.Q.		501				IE"H"
- <u>7</u>	····· ··· ··· ·				<u></u>	5.39'	25'				Woter 1				۲ <u>، ااار</u>	235	60' ·	<b>4</b> (2)	- 1000	
 ۱۰ ۱۹			 ∫1m1]				<u>بلين</u> استان				<u>م.</u> الانت بيال الانت بيال		ىلىلىلەر. ئىلىلىكىنى	(Sand	<u></u>	O		فالملاب	65 85 1111 / <del>///</del> 107	
				4		2.1C,2 2rush	4 90' R	f. Life	K"To	Be A	5/51	iou/n	2.W.C	hite	dAc	sheet cess		$\varphi_{\mathcal{P}}$	) ల ్లి nber) (క	
			. To Approx. Loc. o inhole under fill.	-W. Valve -W. Valve	00D5	MARI		39	/R/ -5	how	A. 001-01-1		JØ D			ApproxLocot	D RW.P. 188-100	3'- F. Hyd.	JOH Zach	N OW,
			_ <u>ج</u> ـ ۲	3.8	2,23	0 0	.'	7 1 m	TNRT- C	N T	HIS	SHE	ETT	OBE	150	1	2 0 ×	200 N	۰÷ ۱	
ON	STRU DO, S	CTI	⊊≊ ON	€5 5TA. :ET P	203	+49 5	Ċ	N LT. R/	OF L W ON	INE" I RT.	K <sup>v</sup> EXC	AND	PRE	SEN	T	$\langle \cdot \rangle$			<b></b>	
ON	° Stru	CTI	⊊≊ ON	STA.	203	5 5	Ċ	N-LT.	OF L W ON	INE" I RT.	K <sup>v</sup> EXC	AND	PRE	SEN	T					
:0N) +'(	° Stru	EE	ON She	STA.	203	5 5	Ċ	N LT. R/	OF L W ON	INE" I RT.	K <sup>v</sup> EXC	AND	PRE	SEN	T					
:0N) +'(	STRU 50, S	EE	⊊≊ ON	STA.	203	5 5	Ċ	N LT. R/	OF L W ON	INE" I RT.	K <sup>v</sup> EXC	AND	PRE	SEN	T					
:0N) +'(	STRU 50, S		ON She		203	5 5 	Ċ	N LT. R/	OF L W ON	INE" I RT.	K <sup>v</sup> EXC	AND	PRE	SEN	T					
:0N) +'(	STRU 50, S		ON SHE	STA.	203	+49       -	Ċ	N LT. R/	OF L W ON	INE" I RT.	K <sup>v</sup> EXC	AND	PRE	SEN	T					
:ON) ) *'(	STRU 50, S		ON SHE		203	<b>149</b>	Ċ	N LT R/ DR F	OF L W ON	INE" I RT.	K <sup>v</sup> EXC	AND	PRE	SEN	T					
20N	STRU 50, S		ON SHE		203		Ċ	N LT R/ DR F	OF L W ON	INE" I RT.	K <sup>v</sup> EXC	AND	PRE	SEN	T					
:ON) + (	STRU 50, S		ON SHE		203		Ċ	N LT R/ DR F	OF L W ON	INE" I RT.	K <sup>v</sup> EXC	AND	PRE	SEN	T					
:ON) ) *'(	STRU 50, S		ON SHE		203		Ċ	N LT R/ DR F	OF L W ON	INE" I RT.	K <sup>v</sup> EXC	AND	PRE	SEN				+78 590/7-1		
CON)	STRU 50, S				203			N LT R/ DR F	OF L W ON	INE" I RT.	K <sup>v</sup> EXC	AND	PRE	SEN						

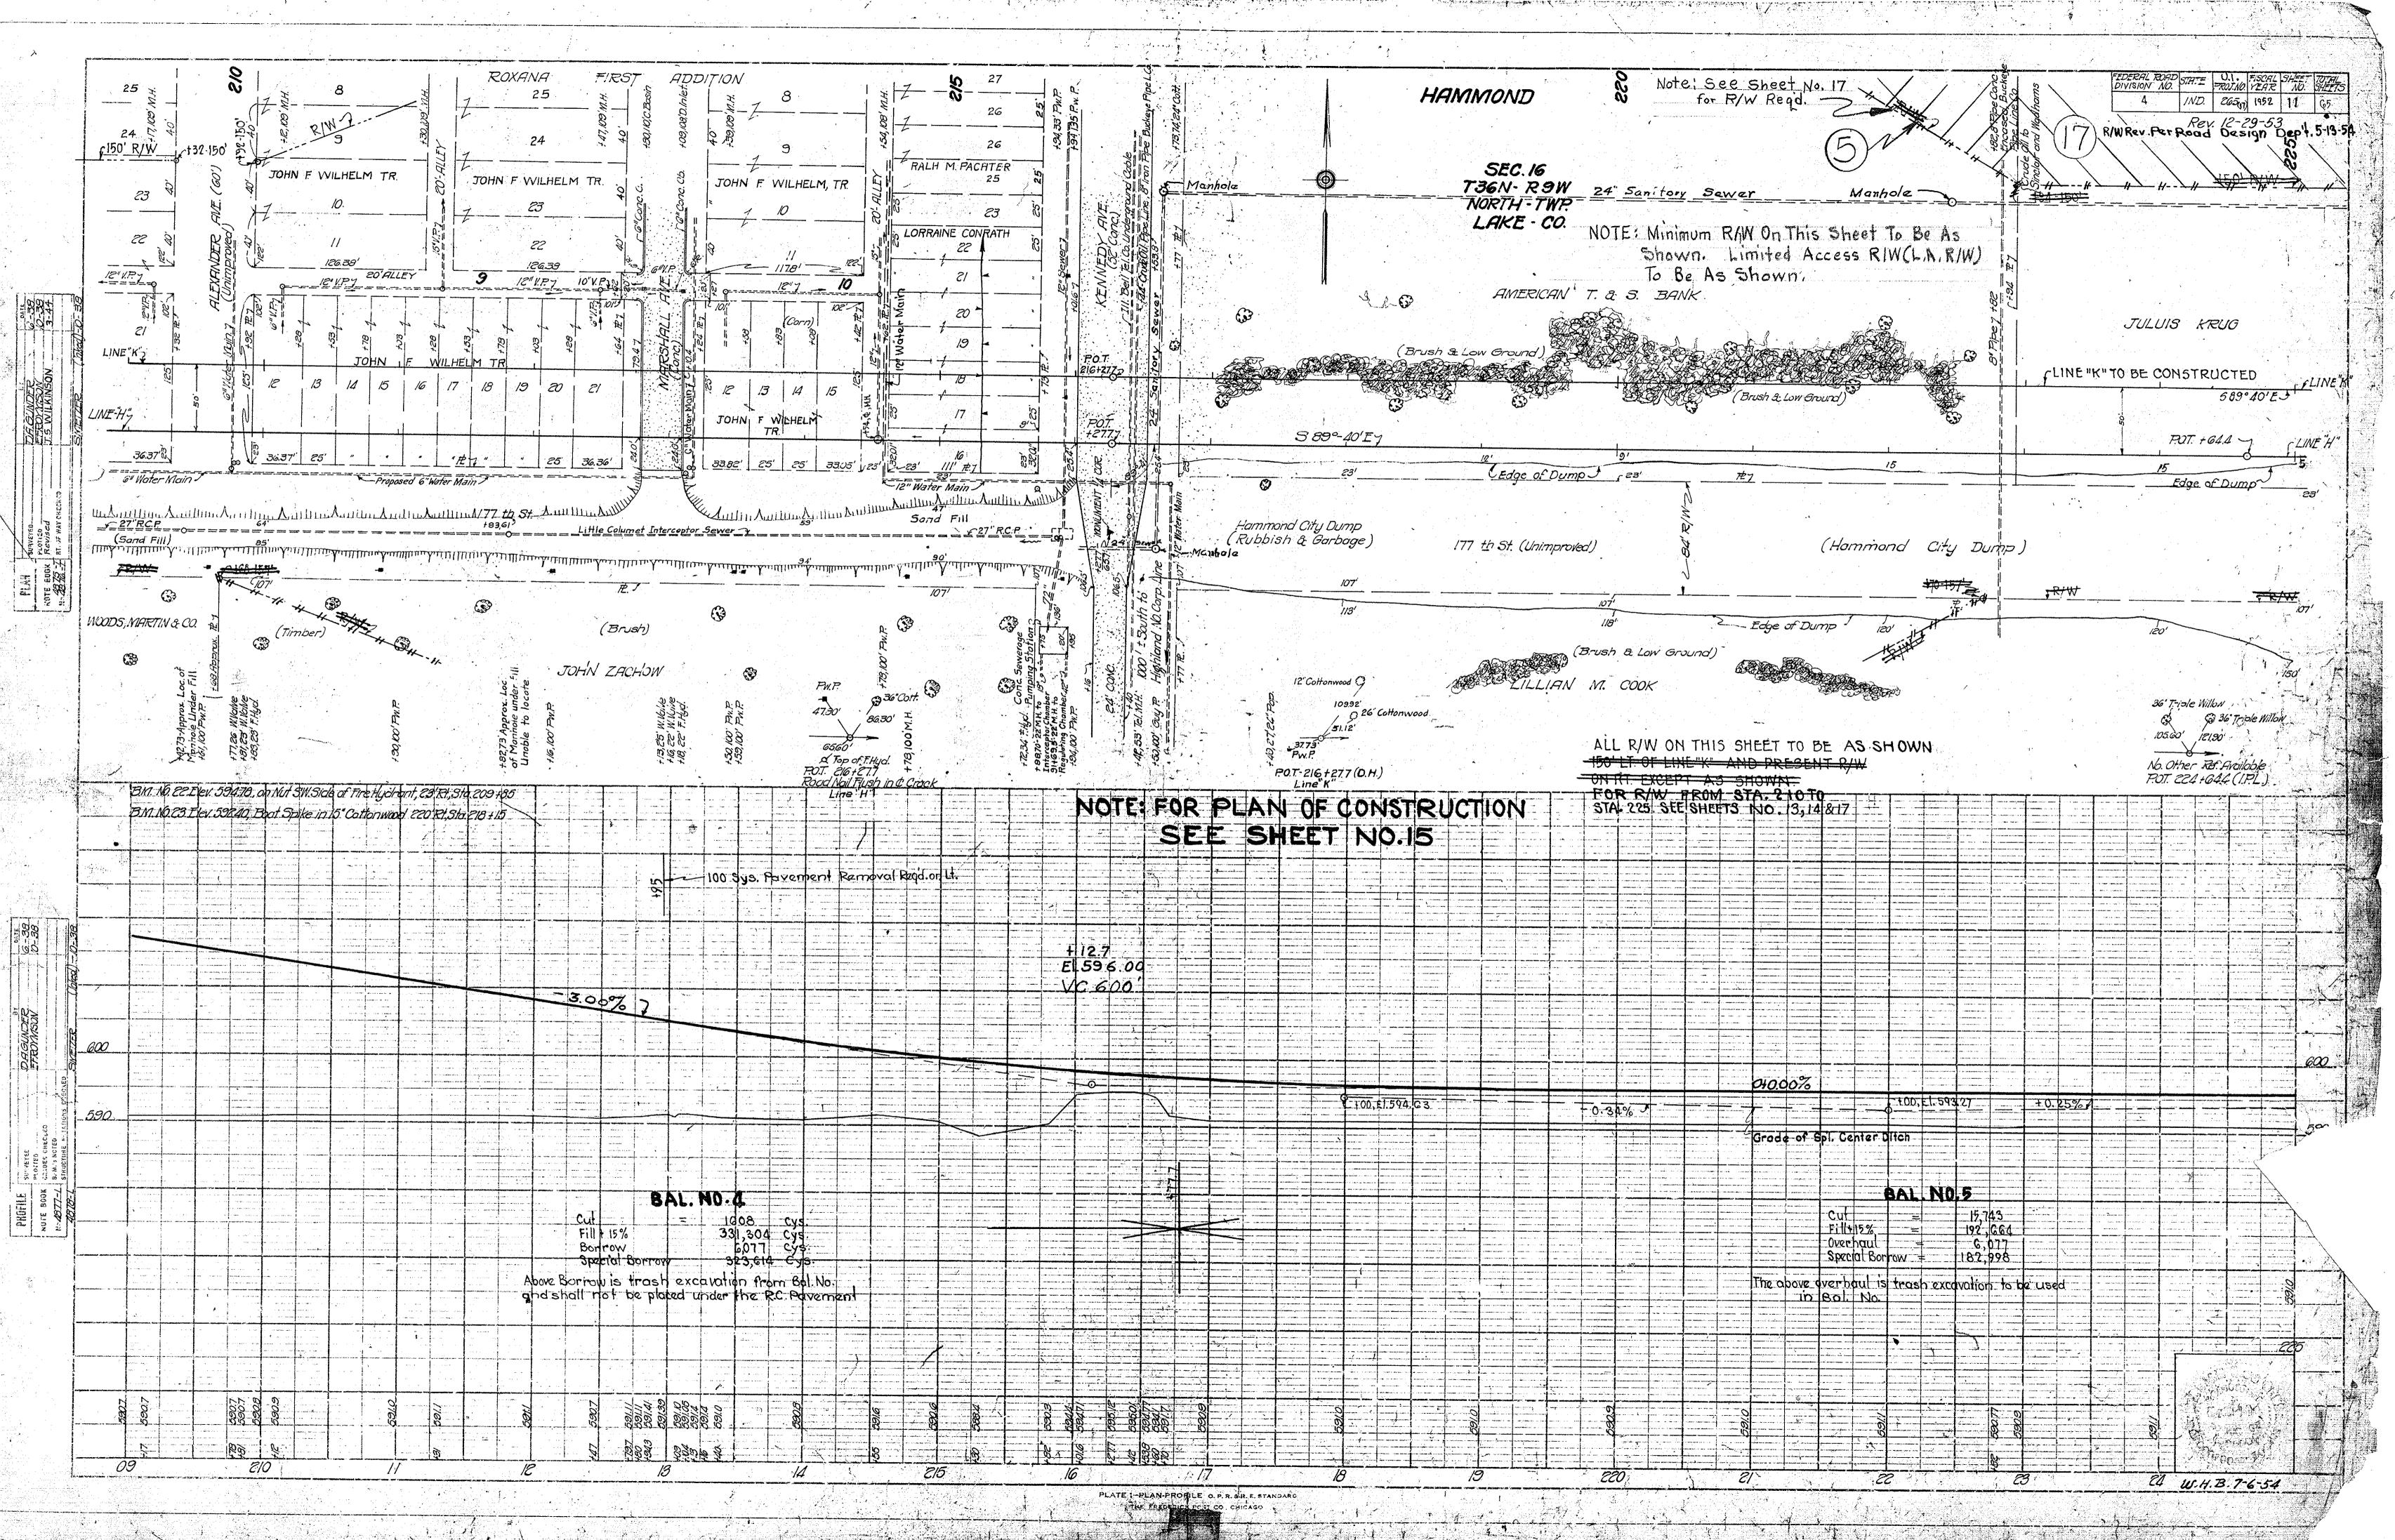


Constant of the second s - 16 March 1

------

And the second barries and the second se

15-24-5

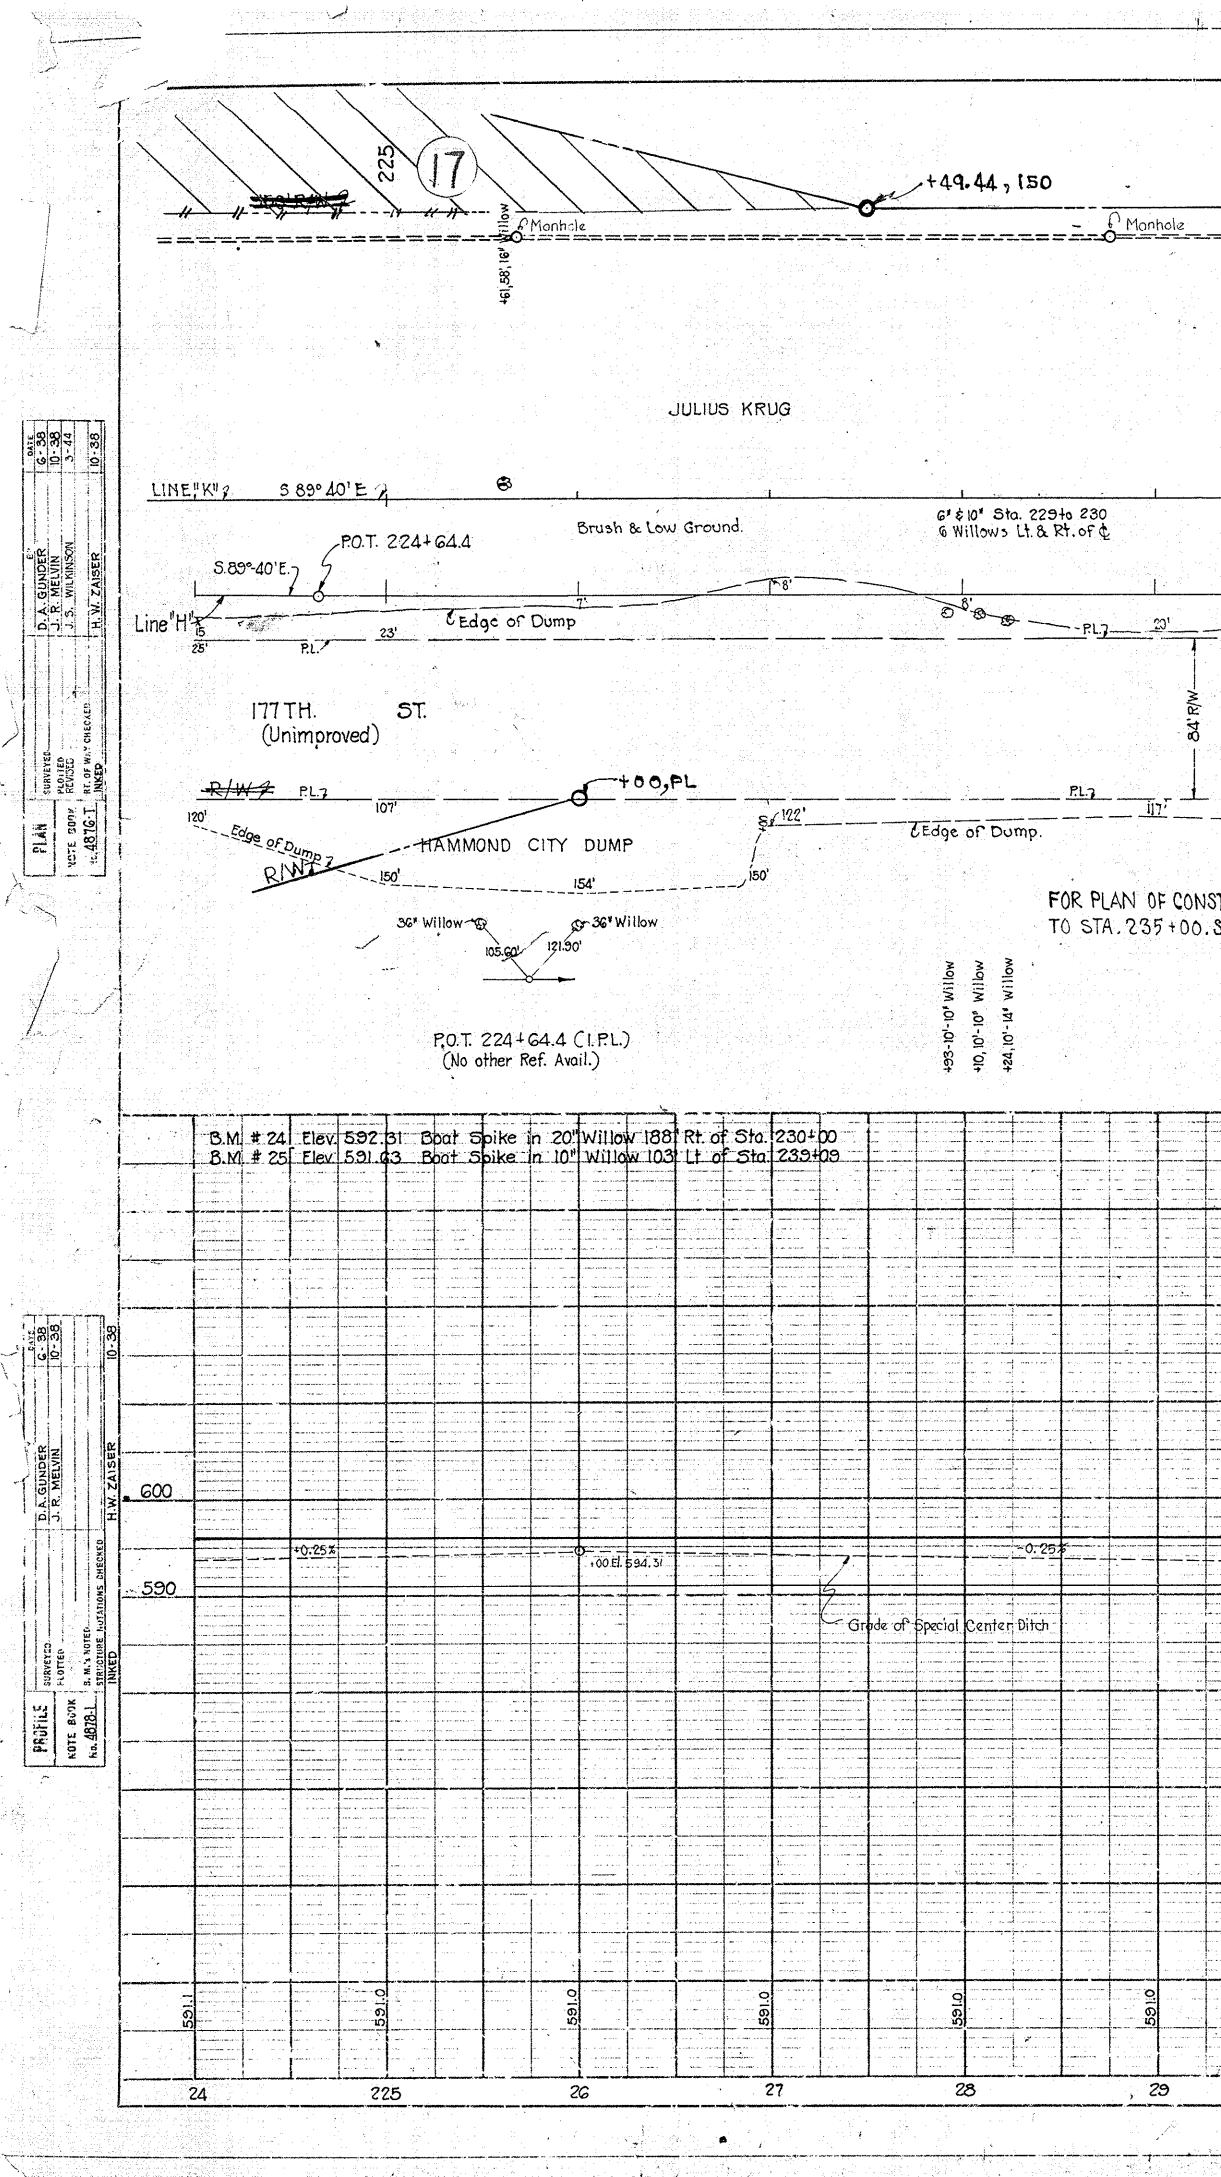

X. . . . XX. . . .

		 				-	· · · · · · ·		•	en and and and a gen 2 					•				•	. :	-	Lanaanaanaanaanaan		
		0×0	2										• • •			•				•	· .	с Л	0	
		ň	ן ן ן					150	'R/V	12		€ Man	hole			-		-				) 	1040 <del>0000000000000000000000000000000000</del>	
			<u> </u>		<u> </u>	<del></del>					<b></b>			OF	F	AN	IMC	DNE	5			· · · · · · · · · · · · · · · · · · ·	Manha ————	
	4	ی ۱۰۰۰۰۰۰ ۱۰۰۰۰۰۰۰ ۱۰۰۰۰۰۰					· · · · · · · · · · · · · · · · · · ·			-@	)-	ΝΟΤ	E: 1	Aini	mur	n R		On "	This	s Sf	ieet	То	Be	Ă٤
	14 09+										ی ایک ایک ایک ایک ایک ایک ایک ایک ایک ایک ایک ایک ایک		1	1 A A A A A A A A A A A A A A A A A A A	1. S.		miter	and the second second		is R	/W (	L.A	, R/W	)_ _/
· · · · · · · · · · · · · · · · · · ·					A	MERIC	CAN	1.\$5.	BANK										. *					
			<b> </b>	-			L			N 1		÷			· · · · · · · · · · · · · · · · · · ·	. ·	 	1		70 + 02	25		ľ	LIN
									· · · · · · · · · · · · · · · · · · ·	· · · · · · · · · · · · · · · · · · ·		(1	Brush \$	Low L	and)	· · · · ·			Sta. 2 100' of	30 to 22 € Rt.≠	י דן גאנא נולדי בל	n Nillow	s - 6" +	o 12"
			Г 11	. 100,	0		  3'	TEC	Ige of	Dum	<u>р.</u>				5'	······································								
· · · · · · · · · · · · · · · · · · ·			23'						<u>.</u>		• •			· · · · · · · · · · · · · · · · · · ·		* <u>*</u>				· · · · · · · · ·	_		End of Dumpi	
(1	Brush -	Low Lon	d)						• • • • • • • • • • • • • • • • • • •		· · · · ·									177	' TH.		0 End of	
	÷				*		•		R/I	NP							Wat	er Edge	)			-94	004 B/	
						<u>E</u>	dge of	<u>f</u> Dumr	· · ·		125'						AFT.		······································			10	? <u> </u>	
STRU(		IAN N				•	i i E	IORTH B S CORPO SETWEET	N HAM	LINE -				776		ALUN	NET							
<ol> <li>A. A. A. A.</li> </ol>		TNC							ILAND	171	-								· · · .					
	32" 71	W.Willow	N <b>Q</b> 26	s" Tw. W	illow	1								CME		••••			CM.P		IY	Ur	HI	JM
	21/2 (	up. Q 13	591 591 591		5 14" W1 8 14" Wi		•							59'\$71'-15		· · · · ·			23'\$12'~15'C.M.P	2				
د میں بیک کی اور		PO	т.230	100.0	(W.H.L	) 		. Formerstein in an an				3		<b>&amp;</b>	······································				<u>ङ्</u> Water	Data				
																	Extre	ne H.	W. El	ey. 592	.2 De	<u>4</u> C. 14, 1	<b>9</b> 21	
													<ul> <li>Annual Construction Construction of the second secon</li></ul>											
																<b>N</b> e 100 een								
				λ - το δημοτικό το το το 					<ul> <li>and the set of the s</li></ul>					an an an ann an Air Ann Ann Ann Ann Ann Ann Ann Ann Ann An				ر بر ۲۰۰۰ ۲۰۰۰ بر ۲۰۰۰ ۲۰۰۰ بر ۲۰۰۰ ۲۰۰۰						
																		معید کر میر مستقد میشد. به در در در با مصرفی می میشد. موجوعی میشد.						
0.0	007						· · · · · · · · · · · · · · · · · · ·				ото с с с с с с с с с с с с с с с с с с								n von en son de la seconda de				· · · · · · · · · · · · · · · · · · ·	
			+00 El.	.593. <i>2</i> 7			+0.33	) 5/6						(	0 ∕+00 El	594.31		<del>~ 0.25</del> %						
	· · · · · · · · · · · · · · · · · · ·							· · · · · · · · · · · · · · · · · · ·															· · · · · · · · · · · · · · · · · · ·	
																	· · · · · · · · · · · · · · · · · · ·							
	· · · · · · · · · · · · · · · · · · ·								· · · · · · · · · · · · · · · · · · ·										· · · · · · · · · · · · · · · · · · ·					
			• • • • • • • • • • • • • • • • • • •	. Aller in the second sec	1 ·	and an	• • • • • • • • • • • • • • •			·				· · · · · · · · · · · · · · · · · · ·	••••••••••••••••••••••••••••••••••••••		· · · · · · · · · · · · · · · · · · ·						a hara ya ka	
	1																							
••••••••••••••••••••••••••••••••••••••		2 1 1 1 1 1 1 1 1 1 1 1 1 1 1 1 1 1 1 1					· · · · · · · · · · · · · · · · · · ·		1 1 1 1 1 1 1 1 1 1 1 1 1 1 1 1 1 1 1							an		. <u>j</u> . <u>j</u>				· · · · · · · · · · · · · · · · · · ·		


32 230 31 33 

PLATE I-PLAN PROFILE Q. P. R. & R. E. STANDARD


. Je je


34


235

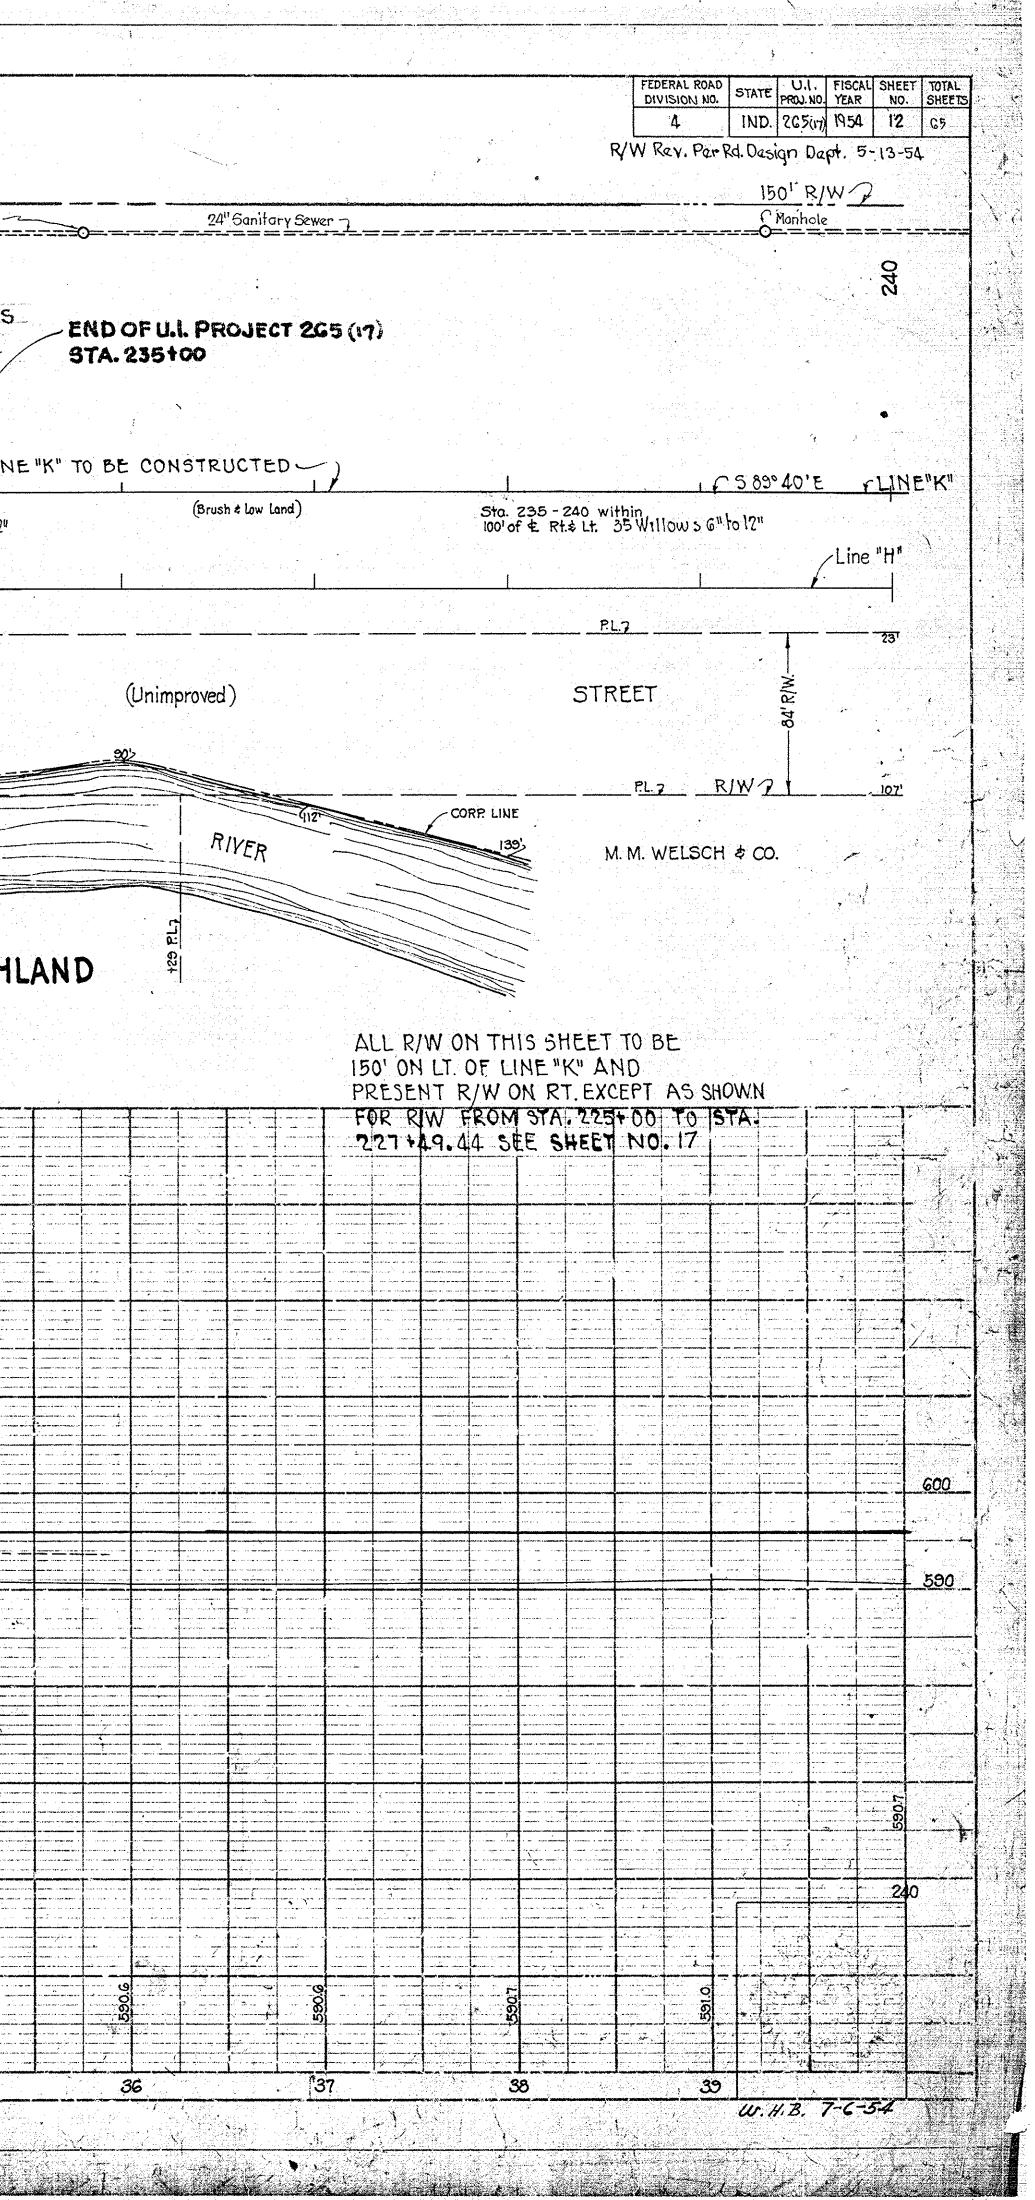


1 -2

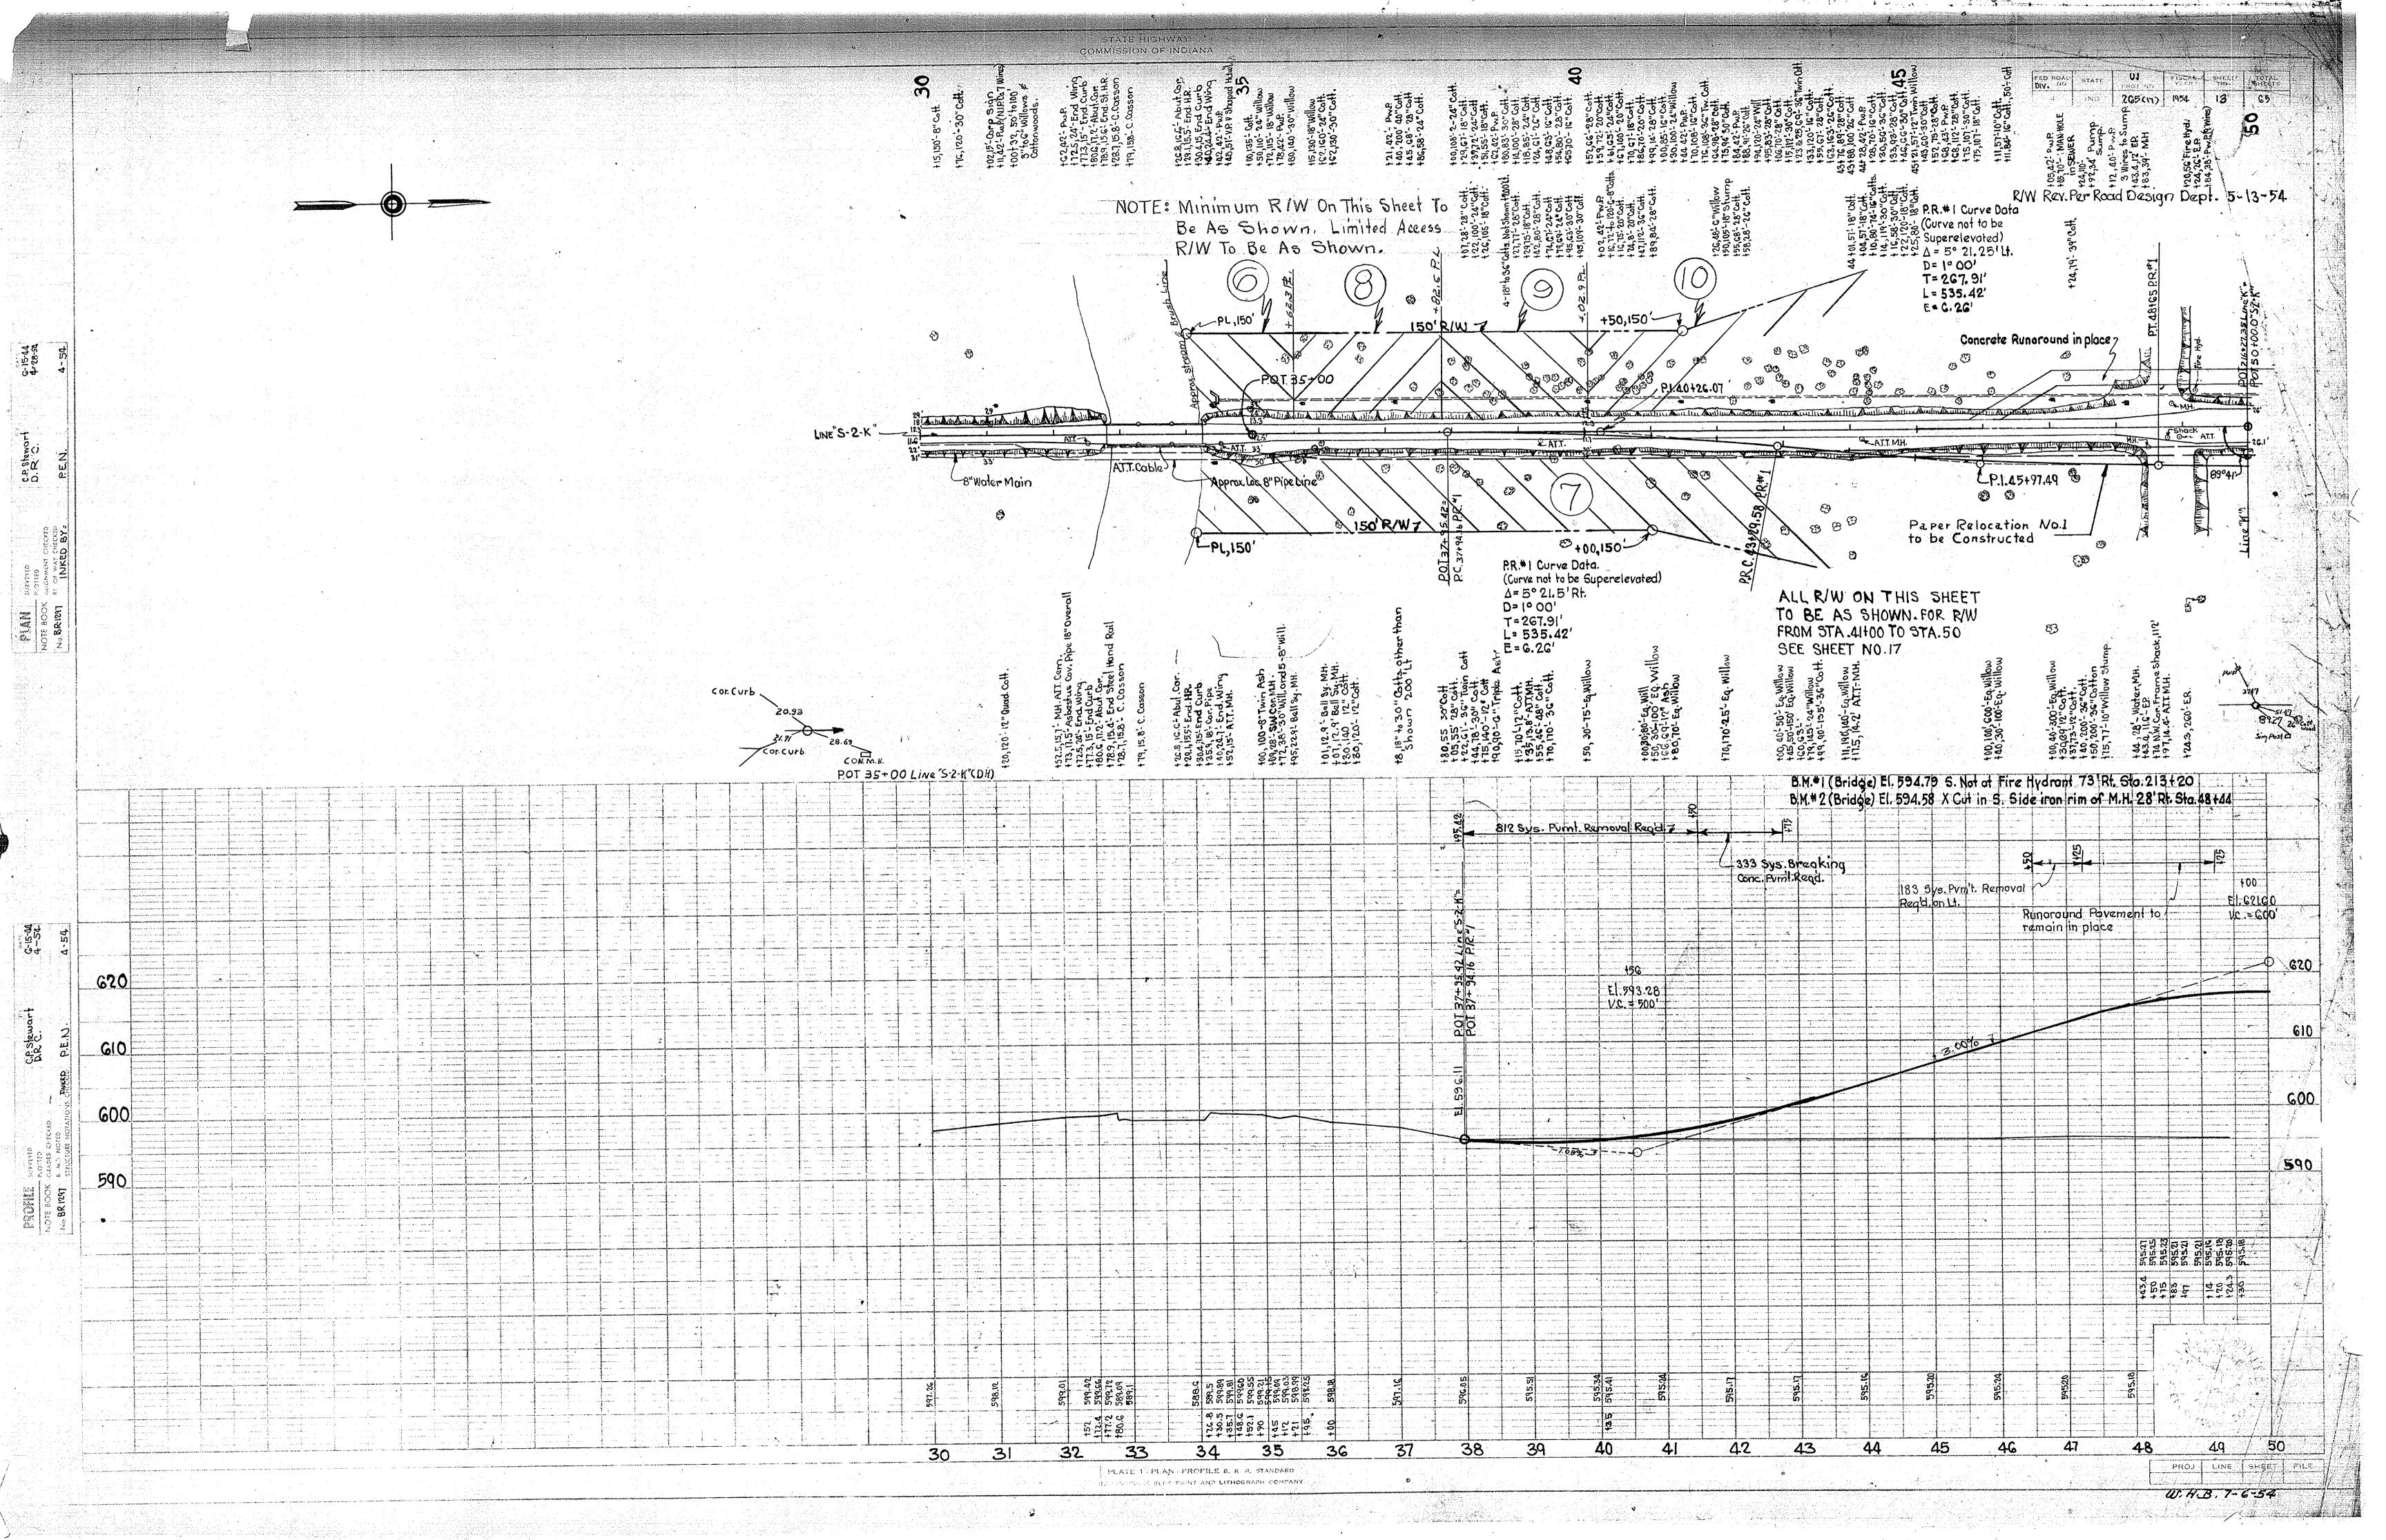

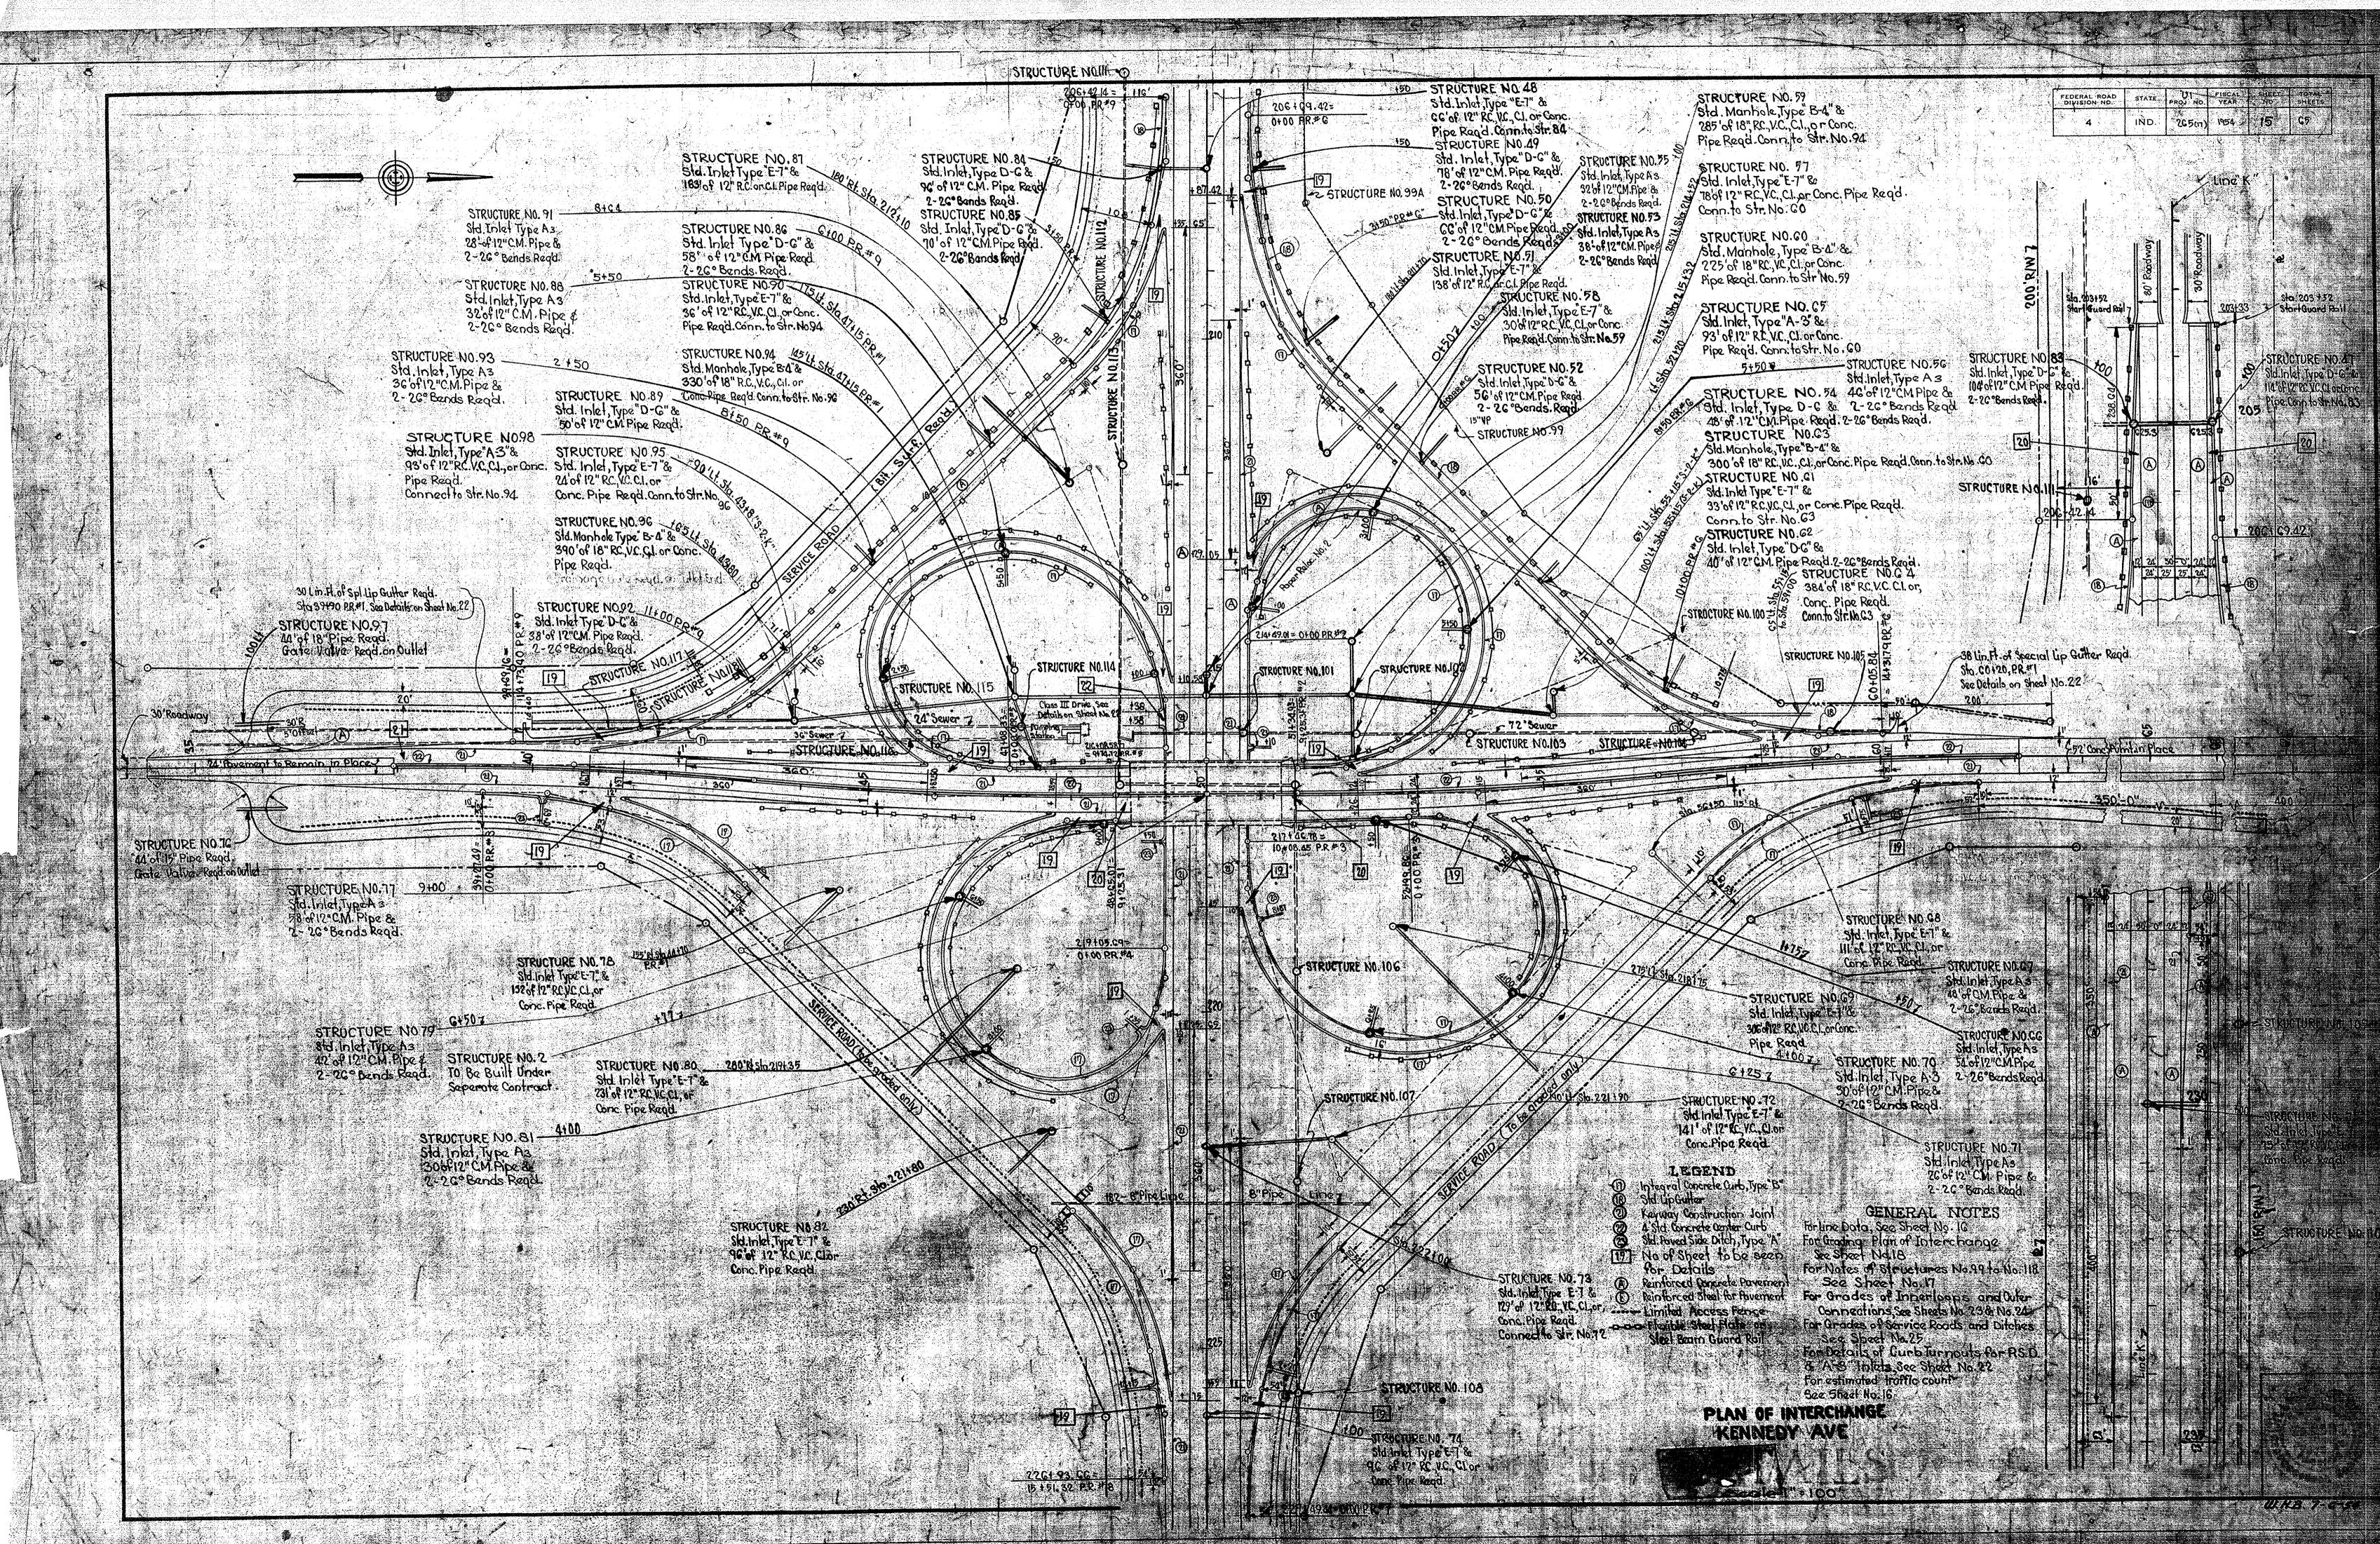


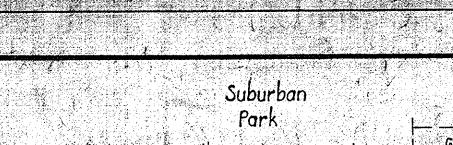



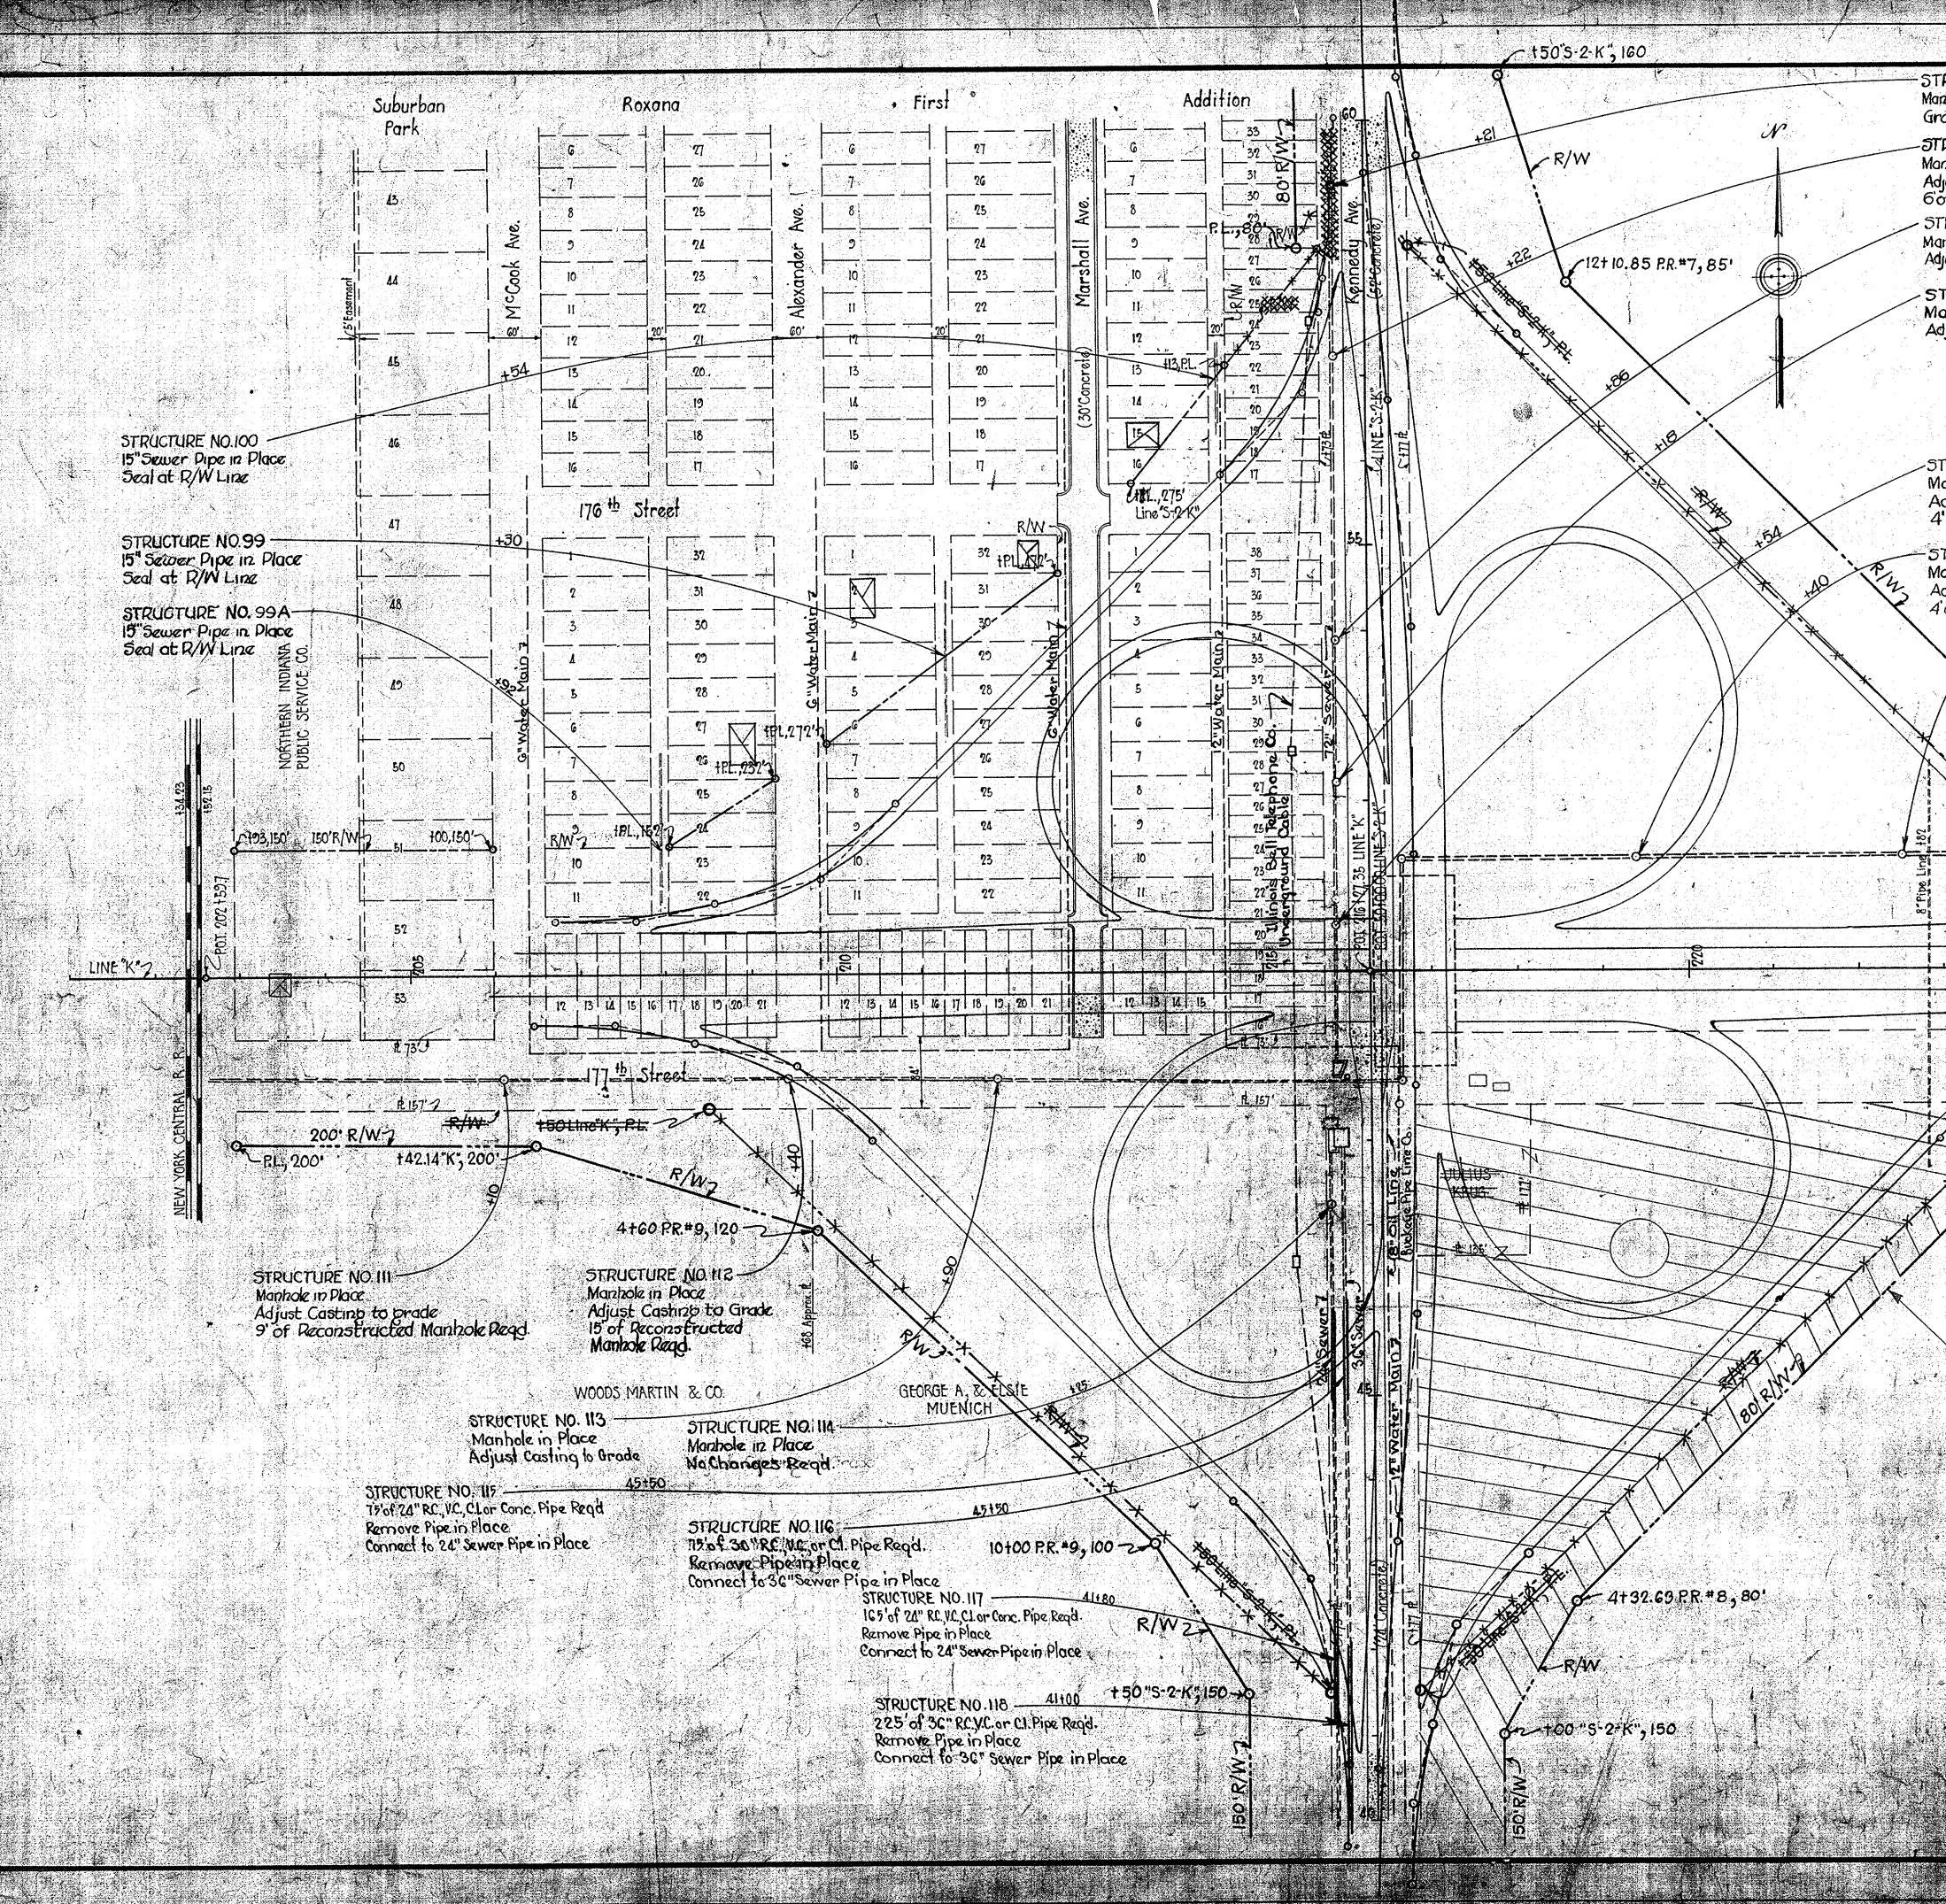

in and in the second se			
TRUCTURE NO. 105 Ianhole in Place. Adjust Casting to Inade, 5 of Reconstructed Manhole Rego	T FEDERAL BOAD DIVISION NO.	STATE PROJ. NO. PISCAL SHEET TOTAL STATE PROJ. NO. YEAB NO. SHEETS IND. 265(17) 1954 17. 65	
ITRUCTURE NO. 104		1-51 Per R/W Dept. 5-13-54 per Road Design Dept.	
Adjust Casting to Grade Sof Reconstructed Manhole Read STRUCTURE NO. 103 Manhole 12 Place			
Ngust Casting to Grade STRUCTURE NO. 102 Nanhole in Place			
Adjust Casting to Grade			
AMERICAN TRUST & SAVINGS BANK OF HAMMOND (TRUSTEE)			
STRUCTURE NO.101 Manhole in Place Adjust Casting to Grade 4'of Reconstructed Manhole Regd.			
STRUCTURE NO. 106 Marzhole in Place Adjust Casting to Grade 4'of Reconstructed Manhole Read			
STRUCTURE NO. 107 60	STRUCTURE NO. 108 Manbole 12 Place Adjust Casting to Grade	STRUCTURE NO 110 Manhole 12 Place No Chanpes Regd	
	STRUCTURE NO.109		
	No Changes Read		
+00 Line 11 150	<u>x +49.44</u> "K", 150		
8	o		
too Line K., RL. t 157' too "r	<", P.L.		
Y., i i			
$\left(\begin{array}{c} \\ \\ \\ \\ \end{array}\right)^{-1} \cdot \left(\begin{array}{c} \\ \\ \\ \\ \\ \end{array}\right)^{-1} \cdot \left(\begin{array}{c} \\ \\ \\ \\ \\ \\ \\ \end{array}\right)^{-1} \cdot \left(\begin{array}{c} \\ \\ \\ \\ \\ \\ \\ \\ \\ \end{array}\right)^{-1} \cdot \left(\begin{array}{c} \\ \\ \\ \\ \\ \\ \\ \\ \\ \\ \\ \\ \\ \\ \end{array}\right)^{-1} \cdot \left(\begin{array}{c} \\ \\ \\ \\ \\ \\ \\ \\ \\ \\ \\ \\ \\ \\ \\ \\ \\ \\ \\$			
LILLIAN, M. COOK	NOTE: FOR LINE DATA O	and a start water water and a start and a start of a start water and a start water and a start water and a star	
	PLAN		
	PLAN of RIGHT OF INTERCHA	WAY /	
	IN IERCHA AT KENNEDY SCARE = P*+10	AVE.	
	SCALE:= !" • IO		

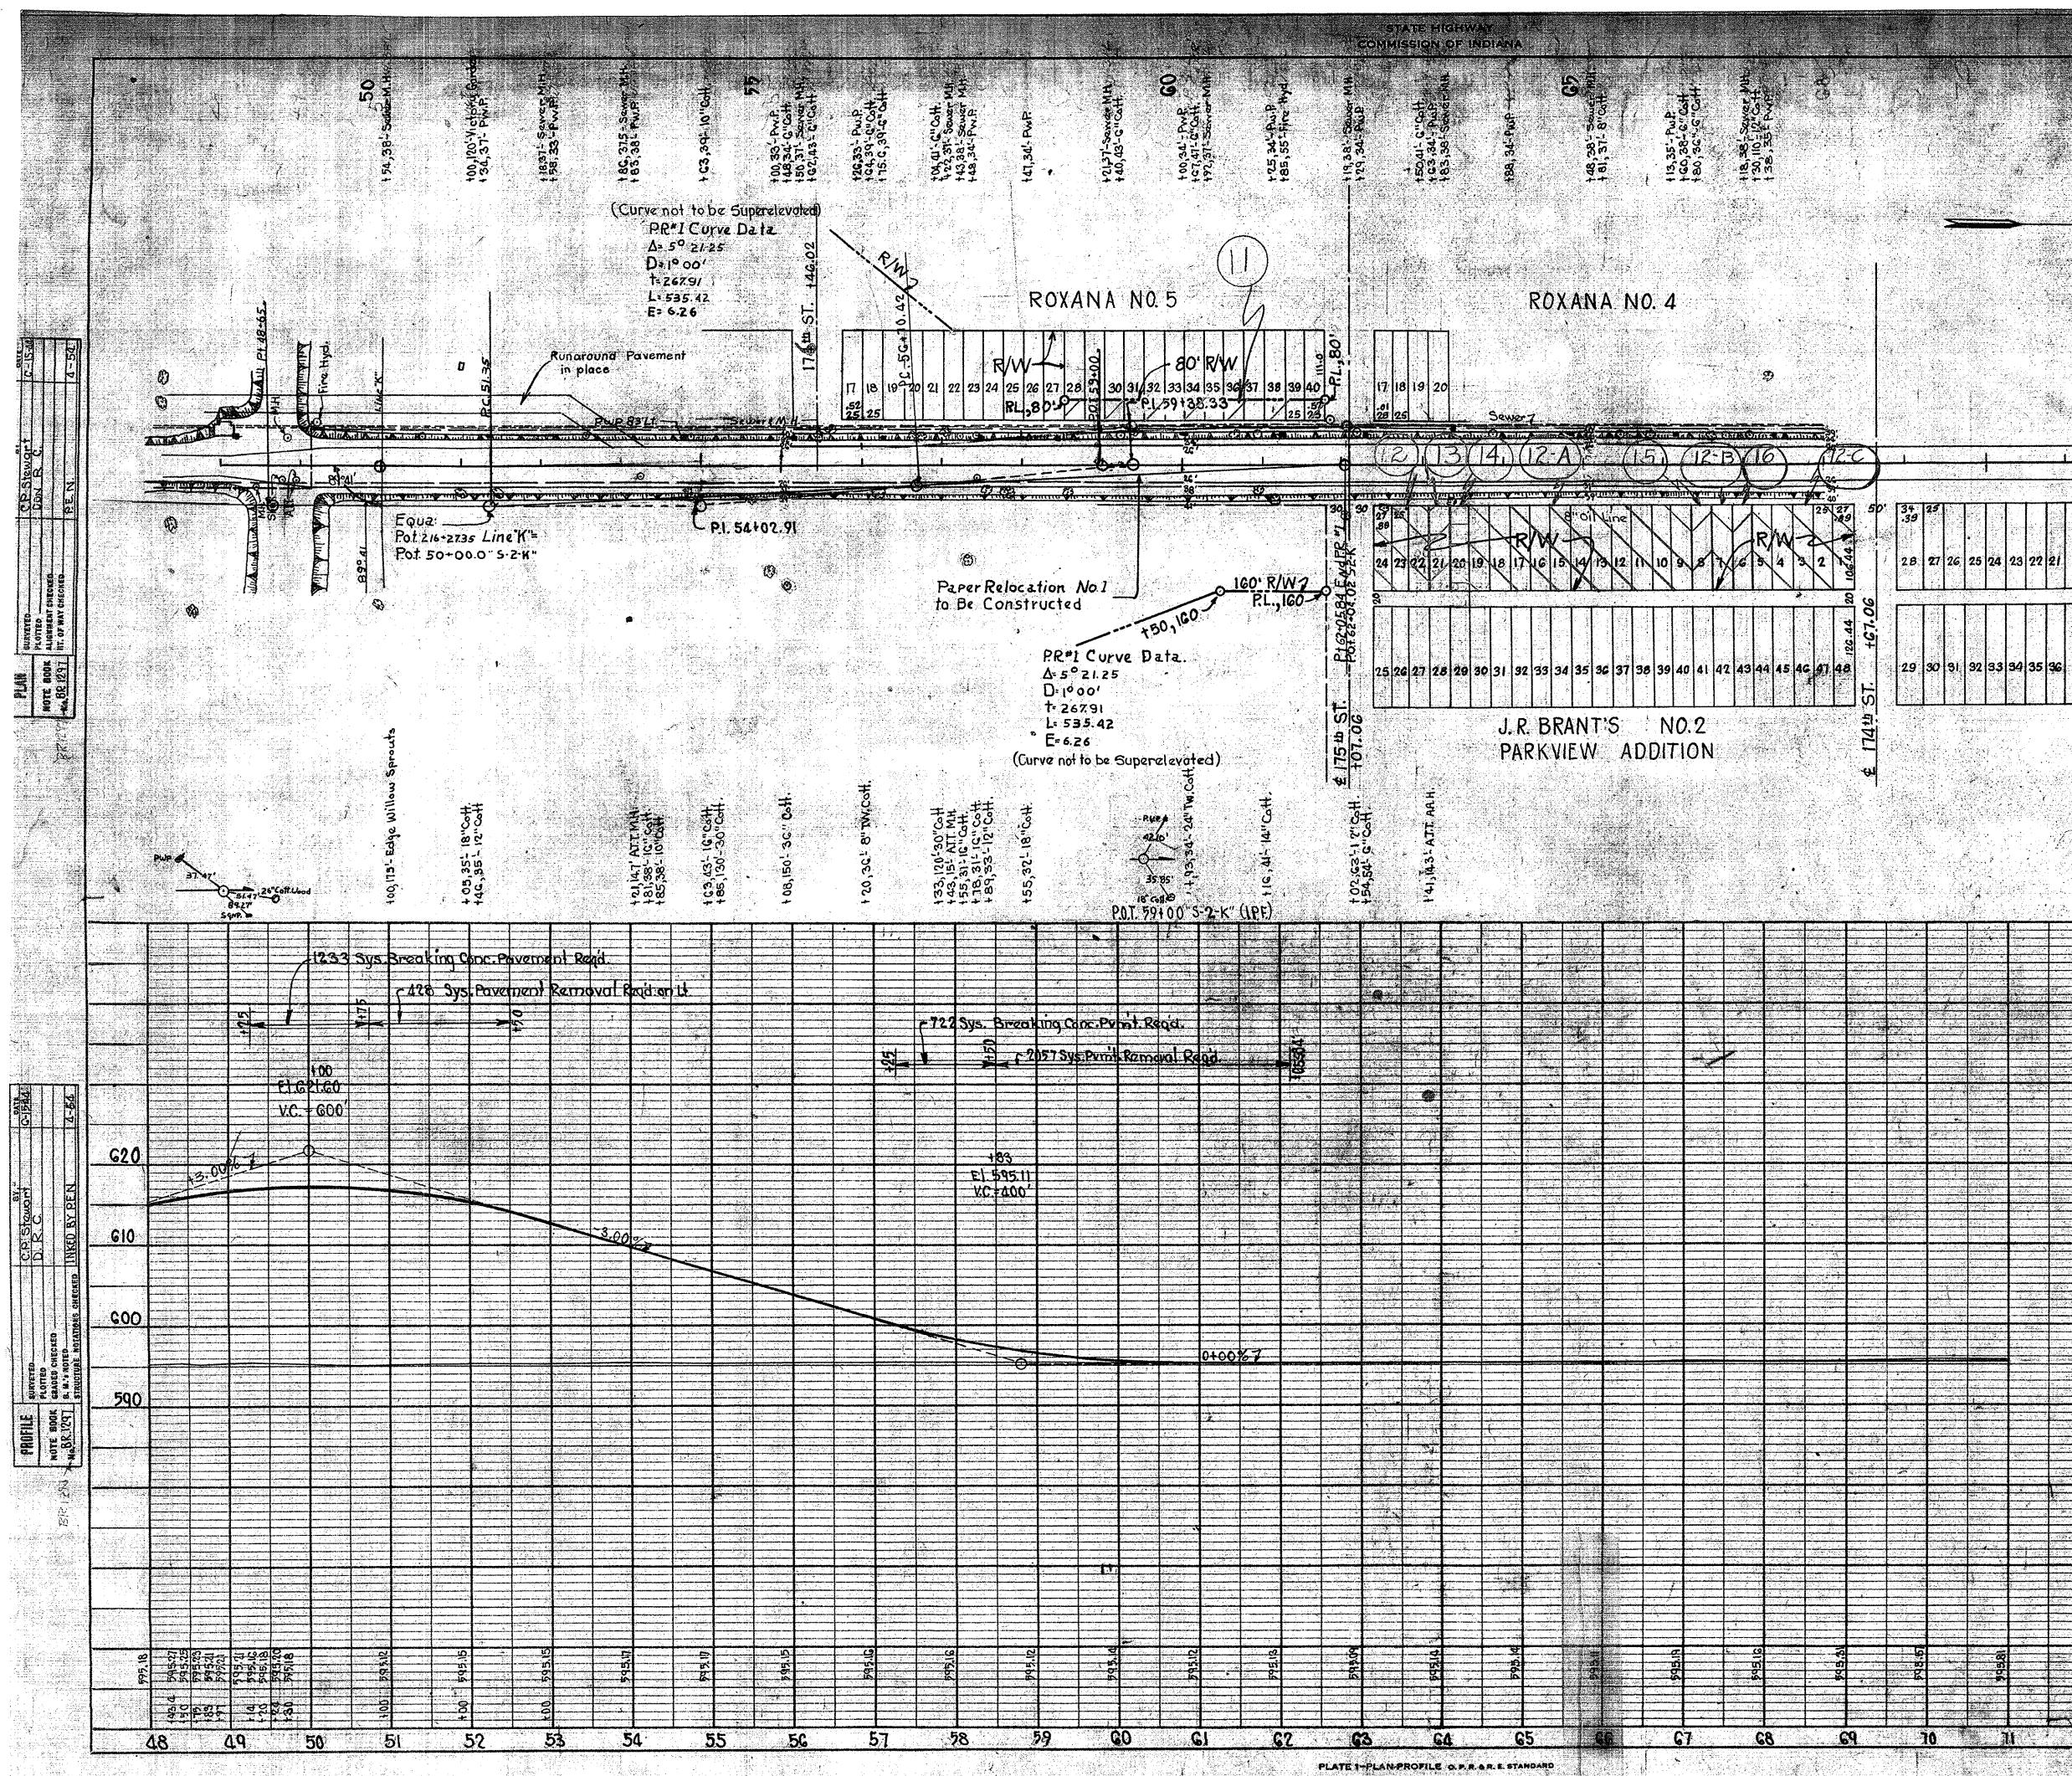

. THE FREDERICE POST CO\_ CHICAGO

## EDERAL ROAD STATE PROL FISCAL c Ind 26503) 1954. 1.4 65 R/W Rev. per Road Design Depit 5-13-54


## = NOTE: Minimum RIW On This Sheet To Be As Shown. Limited Access RIWI(L.A. R/W) To BEAS Shown,

J.R. BRANT'S NO. I PARKVIEW ADDITION

ALL R/W ON THIS SHEET AS SHOWN FOR R/W ON RT. STA. 50+00 TO STA. GI+00 SEE SHEET NO. 17

W.H.B. T-6-54

													an angert					1.	we are the little of the
		8	M NA	3 (B	idda)	Fir 50	4.58	X Ci	in 4	Side	tran	of MI	1.28	R	sta. 49	+44			的名词复数
													~~~~						
		<u>.</u>	M. NO.	4 (-01	idge)	21.59	4.82	91-56	Ke-In	Pw.F.	-33-1	1.510	. 68 *	60		CAN LOOK	19-19-19-1		an interimation
1997 - 1997 - 1997 - 1997 - 1997 - 1997 - 1997 - 1997 - 1997 - 1997 - 1997 - 1997 - 1997 - 1997 - 1997 - 1997 - 2000 - 1997 - 1997 - 1997 - 1997 - 1997 - 1997 - 1997 - 1997 - 1997 - 1997 - 1997 - 1997 - 1997 - 1997 - 1997 - 2000 - 1997 - 1997 - 1997 - 1997 - 1997 - 1997 - 1997 - 1997 - 1997 - 1997 - 1997 - 1997 - 1997 - 1997 - 1997 -			Gyatarak india Churcha (C.24	ار این میرد. و برای مربق میشود دارد.	n an an an Argendaria. Daoine an Argendaria	North Concession Concession (Concession)	ingen som	interiore dan Disebut dan	an the second second Restances of the 200	ges en ens Recenter est	n an		la de la composition de la composition A poste de la composition de la composit	na se antis de la composition Calaborationa de la compositione		ار و این کار دیک برای محمد افغان کار در ا		1997 ( 1997) 	
	2																		
	2. (2) 2. (2) - (2) 2 2. (2) - (2) 2	a contration of a	Se	1 + 1 + 1 + 1 + 1 = 1	Start Start	lan ayan sa aya	State of the second	Magers 27 45	Extransi Isaasii	કુર્બા સારા આવ્યું છે. કુર્બા સારા આવ્યું છે.	a definition of the		V Standard	Star Star Star	ward ywy	er week of the	2.2000000000000	e abastaseres	A REAL AND A
and a state of the second s		anero de			la prostantina Basti ang kan	internationalist Notes de la compañía	al an		میں بیٹر کر		e Veringhalen ja reden veri Serengen serengen se	i singan da karan Ana tarangan da kara	در باز میشد از از باز این اینده شده از منابع با		and the second sec			- 1995 - 1995 CUPACETO ANTI DE
																		10.000.00	and the second second
	<u></u>		8 8 4 4 A A A	Service and the service of the servi	Centre - Es		والمؤلم المراجع والمراجع							$(\alpha_{2,1}, \alpha_{1,2}) \in [\alpha_{1,1}, \alpha_{2,2}]$		17:18 - 7 W	ngerei wit e		2.2.4
an an the state of the second s			a start a transformer to						an a					and the second second		and the second s			
										() () ()									
	Contraction of the second		n an	6.3			in an air ann. An an Airteann	5.27 S. V. S. S. B.	en en de la composition. En est de la composition de la composit	and the second		A RELATION	27 8 204 X 4	indexes and a second	A grant and a	1999 - 1997 - 1997 -	1	ALC ME CARACTE	
	<u> </u>				Conside Berlin-					<u>- 975-27-27-3</u> 14-1-3-1-1-1-1-1-1-1-1-1-1-1-1-1-1-1-1-1					32	-		6.2	
		مىسىيە ئىلىمىيە ئۇرىلىيە ئىرى ئەكەر مەلىرە ئىلىمى ئەرىكە ئەتىم			-1995 - 1995 - 1995 - 1995 - 1995 - 1995 - 1995		545 - 1 4 ( + 3 ) ;		Service and States			2.2				and the second			
2. 		energiane de la compositione de la Compositione de la compositione de la	ni a stati Gradina	المرينية (1995) الرواية مرينية المواقي		23544839 241132			27. 3889 21. saster 18				and the state of the						
		· · · · · · · · · · · · · · · · · · ·					light an gine Africa The second se						1		1. <u> </u>			<u> </u>	
		ئىتىمىتىيىتىيىتىيىتى بىتىيىتىي		in an an sin an	1997 - 1997 - 1998 - 1997 - 1997 - 1998 - 1998 - 1998 - 1998 - 1998 - 1998 - 1998 - 1998 - 1998 - 1998 - 1998 - 1998 - 1998 - 1998												12 2 1 2 2		
		an a	an a		ىرىيى بىرىيىتى ئۇلۇرى بىرىيىتى	and and the second		anna Vienne office	1.1997 - 1997 12-1997 - 1997 - 1997		art i chi					1997 - Angeler	200 - 1990 - 1990 -	- Joseph and States and Stat	
sinder i se							al interactions and interactions		ryrad ar yw yn yw				NEX SOUTH 1	. Pa, 260 (2)	( <del>P.C. System</del> s)		Carrier 74	- Frenderson S	1.2.2.2.4
									kerain (a.e.)					Y.Y.					L. Service and
and the second secon	ant Street all	2 19 19 19 19 19		na na na sa sa sa Tangana sa sa sa sa	an a			s starting and an	en de la deservation Referències de la deservation de		and and a state of the state of	2000 (A. 1997) 1995 - 1995 (A. 1997)							$1_{\Sigma}$ , $2_{C}$
at the second			4 . Sec. 9 . Sec.	<u>(</u>	en to the start	a keant in the	y.c. yżęcata	994 - Wit 7 -		r se vine man		$\mathcal{L}_{\mathcal{L}}^{(1)} \to \mathcal{L}_{\mathcal{L}}^{(1)} \to \mathcal{L}^{(1)} \to \mathcal{L}_{\mathcal{L}}^{(1)} \to \mathcal{L}_{\mathcal{L}}^{(1)} \to \mathcal{L}_{\mathcal{L}}$			2 <u>74888</u> 3	er og som en er som		17 No. 1999 A. 1998 (N	
								Carles and					an a	Alexandra de la composición de la compo Composición de la composición de la comp				an a	
e a constante da la constante d Esta constante da la constante d			rangan, ser series	en en entres References					a di gilla di se se ca a di di Sectore da manga di	Proposition Proposition	ender gesternen Anweiten er er er	1976 N.C.1 1976 N.C.1	22-22-5-2200 6-244-5-6-670	and the second sec	1962년43 3711년 1719년 1711년 1711년 1711년 1711년 1711년 1711년 1711년 1711년 171	akang si Jinti Tanggan kang	an an an the state of the second s Second second		
eg al signific			<u>) - 20 - 20 - 20 - 20 - 20 - 20 - 20 - 2</u>	1. 1. 1. 1. 1. 1. 1. 1. 1. 1. 1. 1. 1. 1	and the second of the	2 20 20 20 20	and a second	<u> 22. 3</u>	NGS. ANTAN	<u>(</u>	<u>(1997)</u> 		assa. Pater		22 - 22 - 24 - 24 - 24 - 24 - 24 - 24 -		int manual i	1	e
						2000 C						n Agental States and Agental Agental States and Agental States and Agental States and Agental States and Agenta Agental Agental A							
			6278 1999 998 2017 2027 - 27				<u>, industriai</u> Third Constants								and a second				
	<u>.</u>	3890-1-1-1		<u></u>	ala sin albana Tanang	L. L. Santa	منية منبقة				<u>. (</u> . 1997) - (. 1997)	ana an taon an	a an	Constraints	anasatini ( in	. Ann is it is		16•18.484	
(áipeanna tha inair	4		میڈ بیٹر میں شہری جانب											andramates 1910-1957 - Ma	1.000 WK - 2.000		and an an an an an a function		ur i je 🖌
	1. 1. S. D. D. S. C. 2. S.			an a			ang kanang sing sing sing sing sing sing sing si	la de la contra de ser La contra de la contra de ser	andre de la company Incluire de la company	an a									
(Martina)	and the second second		an a		ana sejaripat	and a subject	a di sana di s Sana di sana di	asser and a			an a star star star star star star star st				ومستعبر فهلك المحاسب		n na state de la serie. La serie de la s	n in i Anna Anna Thairt	Concernance of the second
e de la constante da la constan Na constante da la constante da		er er er sinder after Statue er het er h	a san ing pana ang pang pang pang pang pang pang pang p	s <u>ina</u> n ta <b>t</b> atan Tanan tatan	yan yang di sang di sa Sang di sang di	ay a san ay		en or en els Construests	د اینځو در این میرد. در اینځو او د او د د او د د		an a				a an		1	<u> </u>	
tes da la cas	Acres Brokers		an a				and a classification of the second		in for the second s		<u> </u>								
Anne a star			1				ي مي المي المي المي المي المي المي المي	يا رويد يونيا ا				an a				N			100 cm 27 17 2 19 2
							ey a de vier Versieren		1997 - 1997 - andar an						<u></u>	an a	n an an Araba an Araba Araba an Araba	
															10-10-00		<u></u>		
Hereinigen - St			an an tao an Ar				an an an Araba An an an Araba An an Araba			(3. 3. 2. 3. 1. 1. 1. 1. (3. 3. 2. 3. 1. 1. 1. 1. 1. 1. 1. 1. 1. 1. 1. 1. 1.		in the second	n de la factoria de la composición na de la composición d	g ng talan ang sa 2002 Na kabupatén pang kabupaté	ේ දැන්නය. ලංකු විද්යුණු	antana ki matang	na seriesta Nacionalia de Ma	louijakti ±j∦erči	er et son verste son en en er Same - Samer ander en er er er
						2010 - 2010 - 2010 2010 - 2010 - 2010 2010 - 2010 - 2010 - 2010					-						1 1 1 1 1 1 1 1 1 1 1 1 1 1 1 1 1 1 1		
			Reder and a star			ng teoret vijste	100 - 100 - 100 - 100 - 100 - 100 - 100 - 100 - 100 - 100 - 100 - 100 - 100 - 100 - 100 - 100 - 100 - 100 - 100		2		1.1.1	· · · · · · · · · · · · · · · · · · ·							
ka sana sa k Tanggan sa sa sa			ವಿಸಿದ್ದಾನಲ್ಲಿ ಗಳನೆಗೆ ಹೊಂದಿದ್ದ ಸ್ಪಂದಿನ		ang sang baba ang sang sang sang sang sang sang sang s	d salar salar. George salar	en de la composition de la composition Esta composition de la	z ces (opege Stationski	elegi an an aist de ser a Spellige de la segera	or search Staineachta	n presidente de la seconda de la seconda Seconda de la seconda de la	and a second second Second second	्रत्यम् १७२७ १५९४४ - १४९७	2007 - A.C.	antin ing pogo d Angsi addatsi d	ತ್ರಾವರ್ ಹಿಂದಿ ಜನವರ್ಷ ಕ್ರಮ	an a	in the many sets The manual set	aleb, sin 1794a sinesi Karaktura kerangan
									an a					a straight and bearing				- 3 Manin	ia siniti da
	1. a 1. a 1.	e de ser de la composition de la compo La composition de la c	ogen (de la sectaria de la sectaria) Maria de la sectaria d		2.		المتيارية مرتبة المجادية	S. 2. S. 2. 35	تاريخ ورواني المعرف الم			n na sana na sana Na sana na sana sana sana sana sana sana			a san an a				
24	en de la com Recente de la com	Same and the	YANYA SA	in the second	an a	ri ng sa bi ganaki Marina ini tai pi	at the case of the second	naine, coite an Natana gaintíc	and a second and a second s Second second	langer 1928 - La Statisticae - La	andrevni – Alis Augusta – Argan	n an an thair an thair Tha an tha thair an tha	an an an Artan San An An Artan	land the second of the second s	Christian Anna Anna Ann 2017 - Stati	가방을 가지 않는다. 1944년 2월	3 - 2 - 6 - 8 X - 1 	1997 - 1997 - 1997 1997 - 1997 - 1997 - 1997 - 1997 - 1997 - 1997 - 1997 - 1997 - 1997 - 1997 - 1997 - 1997 - 19	a statut de la composition de la compos
el est d'artes Render regione	<u> </u>	*					in the second		an an an Anna an Anna an Anna Anna Anna	en en ser en	i da la come								de la compañía
	18 a 19 a 28	a start and a second					100 - N. 189	e en skrive	an a									1. 10.200 1.1 10.00	
ng Angelen en e	ana an ing ing ing ing ing ing ing ing ing in	ار بازین داشیدی. اور افکار میزان		an a	phinter and a Reference and a	i si se carel Note i al fritari	n e seisike. Seise seisike	en de Hange Statue	ही से प्राप्त अन्ते हैं। सन्दर्भ संस्थलित क					nacinista. Nafategoriga,			から、 後に業業 1995年(1995年)		
		santa∰ da sa Manana da	<u>.</u>		-		al de la companya A companya de la comp	2						See Service					1.2
			ad	a Manager Vike		and in the second	1944 - AMERICA	1979) A. A. A.	1707 - A. 2011					N. C. S. S. S.	net system		17 17 19 19 19 19		and And the first
	4			an in the second se	2. 2. <b>2</b> . 2. 1. 1. 1. 1. 1. 1. 1. 1. 1. 1. 1. 1. 1.	고려가 있는 것 같아. - 전문감이 가 있다.	an an anna <del>1</del> 95. Tha an	an in star i star i sin Sin sin sin sin sin sin sin sin sin sin s	8742) - A. (2017) 6. N. G A. (2017) - A	Carta Carta Carta	l de la composition Referències de la composition	anan seria Deserta deseria		1. 1997 - 1997 - 1997 1997 - 1997 - 1997 - 1997 - 1997 - 1997 - 1997 - 1997 - 1997 - 1997 - 1997 - 1997 - 1997 - 1997 - 1997 - 1997 -	ning said anns Na chùir airrean	n an tha an t Tha an tha an t			
																			and the second of the
						9				en e					L				
<u>a 4</u>			na an an an Seatairtí				1. A.	1	Salan Merri Salah Salah	en e	nen 202. Generati			n an an an a' shugar Shugar (nga tang tang tang Tang tang tang tang tang tang tang tang t		1			names they well for the second second second
	and a second								2-0			P.a				2 2 Cal		Avr. ann 1	
a notes an a c	din e e	1. 1. 1. 1. 1. 1. 1. 1. 1. 1. 1. 1. 1. 1. 1	÷	C. Carlotter C. C. Com	filing a color of							ana ang santa Santa ang santa				263		1924	
		lan san Letters	al al cara an Sa sa	and a second	san ing Kabupatèn Ka Kabupatèn Kabupatèn Ka	na de la calencia. Na seguir de la calencia de la c		₩~* 14 38 8 - 15 4	is an an king. Second State	में विद्युत करते. स्वेत्स्य विद्युत्ति के स्वीत		kana in mangangan Antan Kati	a - Lusia Man	alsie gez det.					
<u> </u>							(* 2000 C	4. g	E. CALE GE		المیں ال المیں المیں الم							Z ST	
ğ	Second Andrews	1		<u>2-</u>	445 CB 8752C	and the second sec	a de la composition Response		n an									2 <b>3</b>	
and the second second	line internet. Station	an a			در استان روید و ردوانه مرکز مرکز در مرکز مرکز م					na station (see	tanta di Santa Ing	in Flore, Volas Ref La ref.	ander af sterne Ar statistister	1999年,他们的现在。 1997年———————————————————————————————————		#15 %/~ <b>@</b> 2\$	್ ಇನ್ ತಿವಿಷ್ಟು ತಿಕ್ಕಾ ವಿಕಾರ್ ಕಾಣ್	<u>_</u> []	n gerte state soore
	1.26.20 10	1. A. A. B. S. B.		an a		and the second				and the second secon		an a	والمحاود محاج والإخراجة						
		and the second se						5. 1		197. cz. 27. st. 27. st.	an a						an in the second se		
	a fa an		21 66.67	R training	n de la compañía de Compañía de la compañía de la compañí	(1,1,2,1,2,1,2,1,2,1,2,1,2,1,2,1,2,1,2,1		êr de ser de	en e	1. 1. 1. 1. 1. 1. 1. 1. 1. 1. 1. 1. 1. 1	Stan ga sera	1999 (A. 1997)	A Tri Alla						

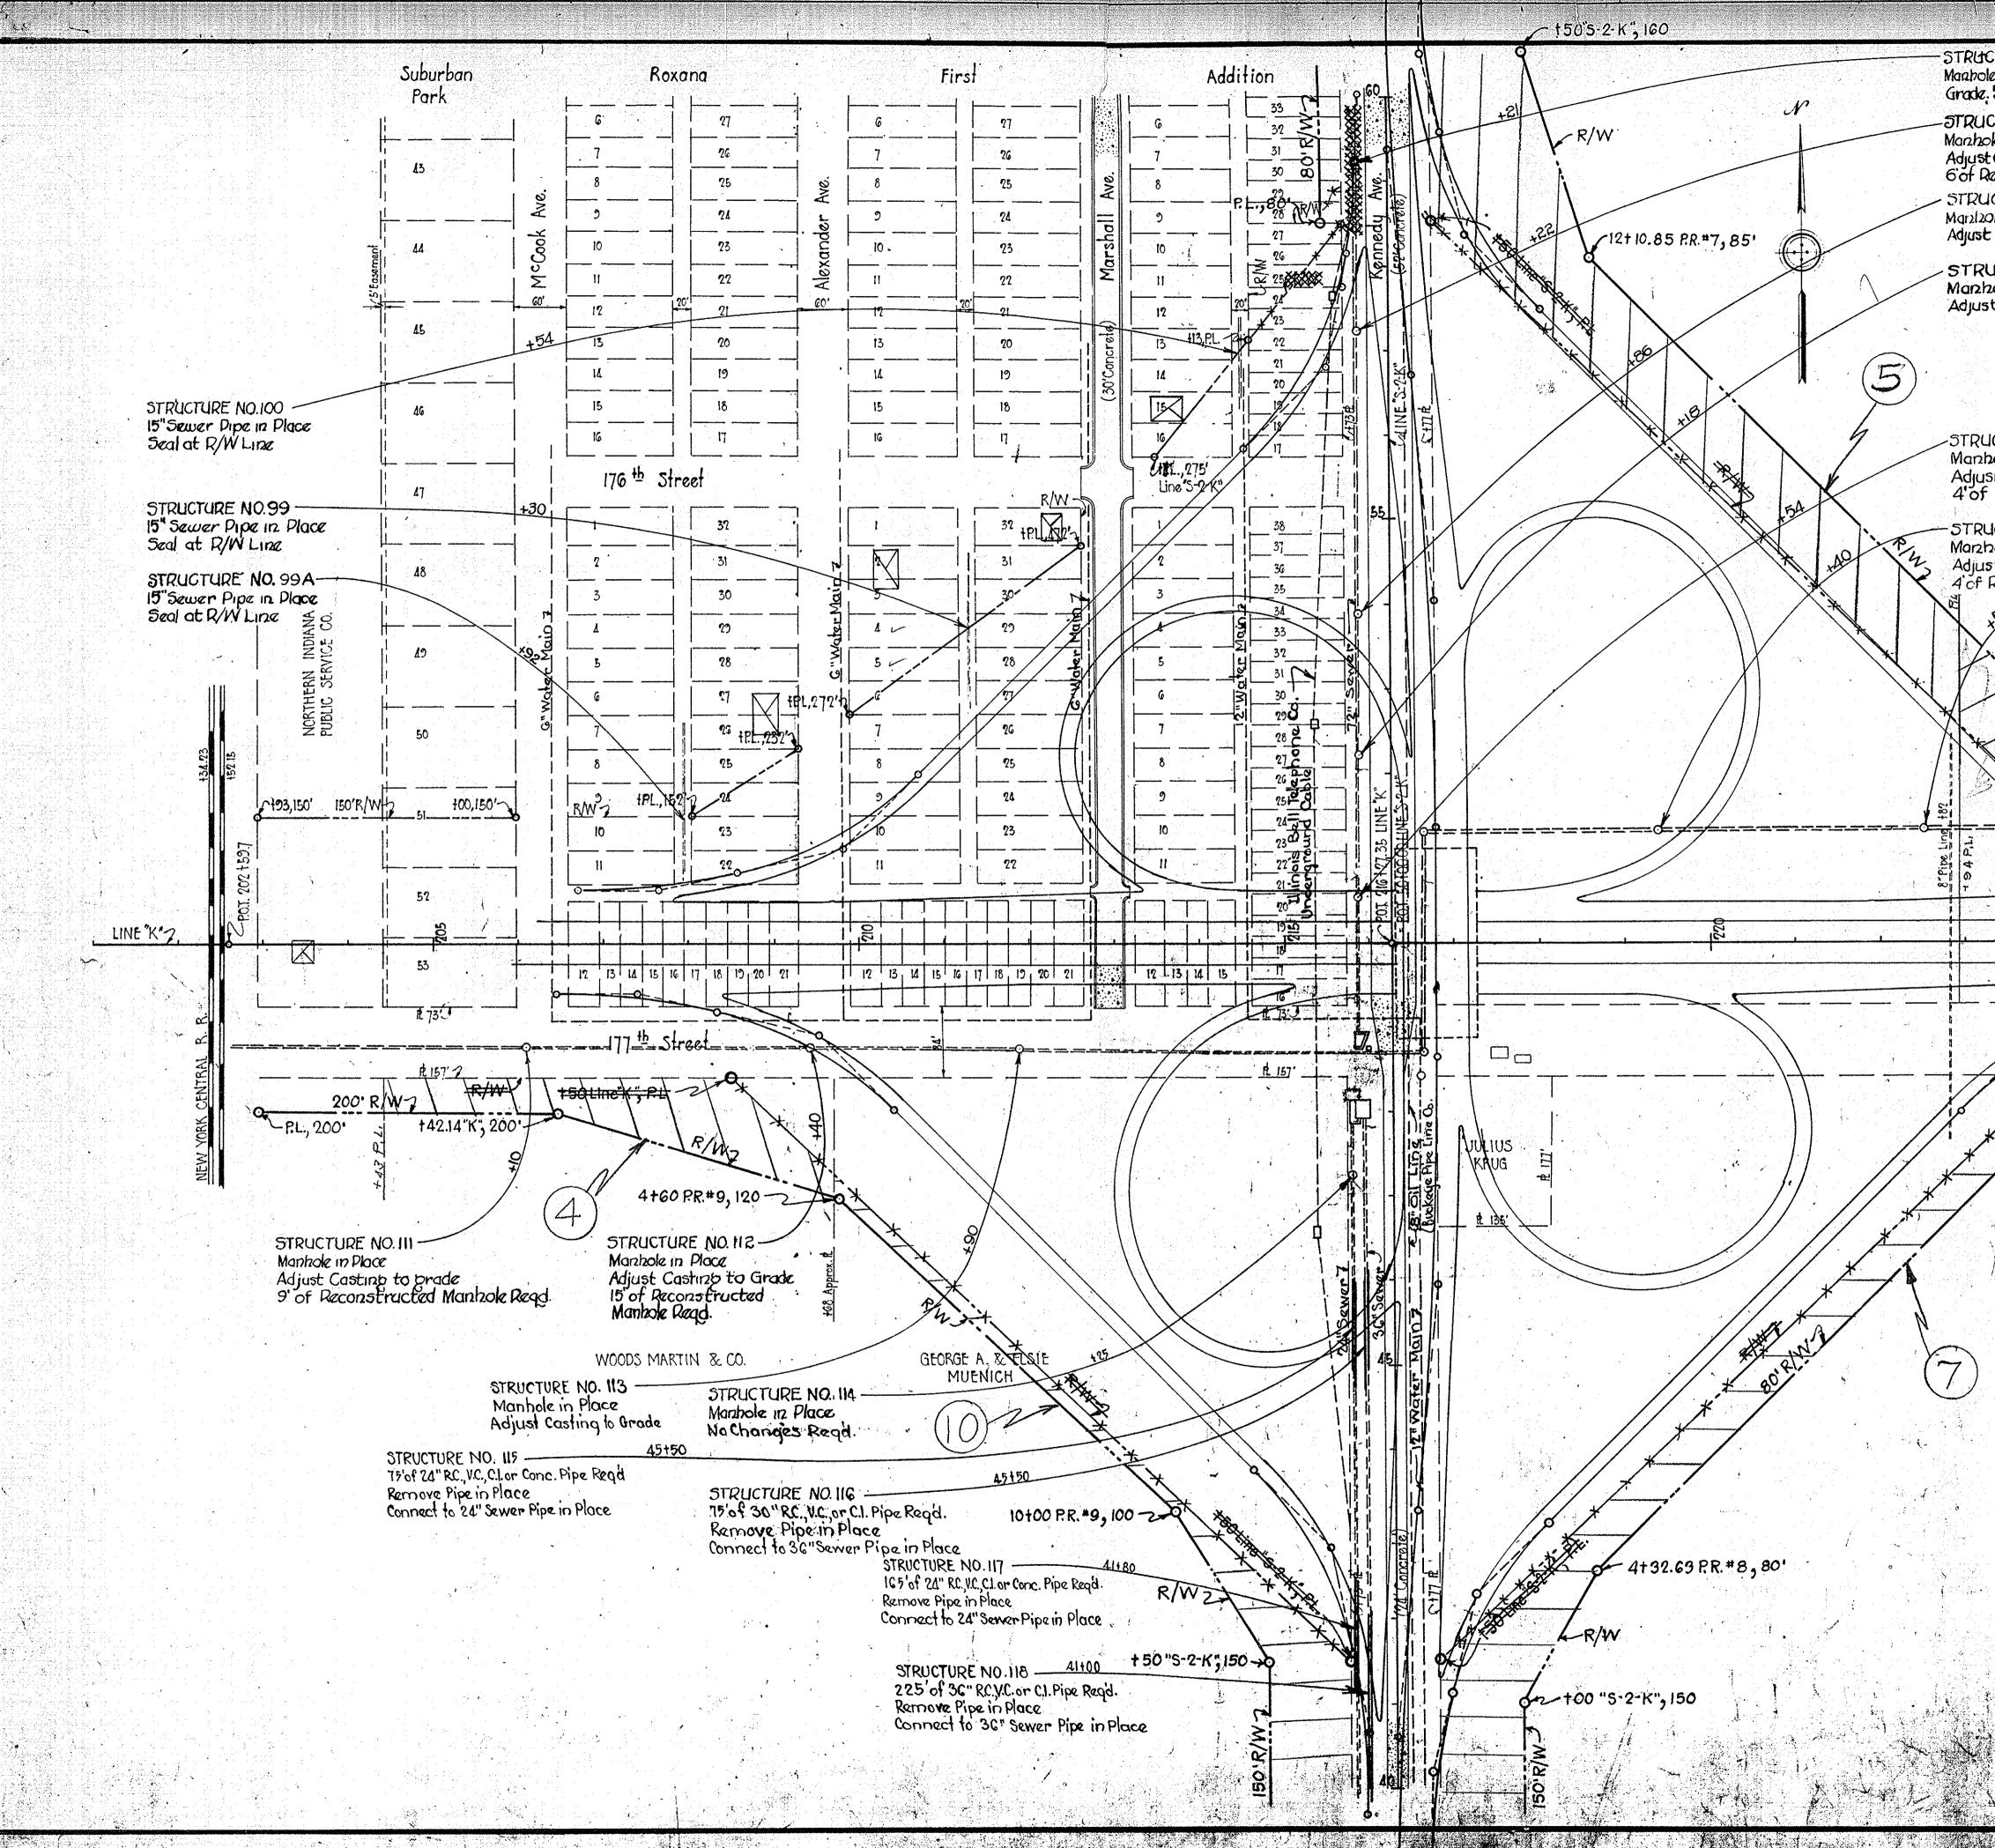

a The second Land and the second s

v


æ, , -STRUCTURE NO. 105 Manhole in Place. Adjust Casting to Grade. 5 of Reconstructed Manhole Regd. FEDERAL ROAD UI FISCAL SHEET TOTAL DIVISION NO. STATE PROJ. NO. YEAR NO. SHEETS IND. 265(17) 1954 17 65 4 STRUCTURE NO. 104 R/W Rev. 2-14-51 Per R/W Dept. Marzhole in Place R/W Rev. 5-13-54 per Road Design Dept. Adjust Casting to Grade 6 of Reconstructed Manhole Regd. STRUCTURE NO. 103 Marizole in Place Adjust Casting to Grade STRUCTURE NO 102 Marhole 12 Place Adjust Casting to Grade AMERICAN TRUST & SAVINGS BANK OF HAMMOND (TRUSTEE) STRUCTURE NO. 101 Manhole in Place Adjust Casting to Grade 4'of Reconstructed Manhole Regd. -STRUCTURE NO. 106 Marzhole in Place Adjust Casting to Grade A'of Reconstructed Manhole Read 了TRUCTURE NO. 107 STRUCTURE NO 110-69-STRUCTURE NO. 108 Manhole 12 Place Manhole in Place Manhole in Place No Chanpes Read. Adjust Casting to Grade Adjust Castino to Grade/ STRUCTURE NO.109 Marzhole in Place -4+32.50 P.R. #7, 85' No Chanpes Read. R/W-\$ +49.44 "K", 150" £ 72'\_\_\_\_\_\_ 100 Line"K", R.L. C+00 "K", P.L. 2 11+18.82 P.R. # 8, 80' LILLIAN M. COOK NOTE: FOR LINE DATA OF PAPER RELOCATIONS SEE SHEET NO. 16 PLAN OF RIGHT OF WAY AND INTERCHANGE AT KENNEDY AVE. SCALE :- 1" = 100'

. . . .

STATE OF INDIANA

OF RIGHT OF WAY COSTS FEDERAL AID PROJECT UI 265 (17)

		ULAULAL LAND	W CICON TWA IN THATH IN	THUR THAT THURSDAY	T) CO2 TO 1030	<u> </u>		
			PROGRAM APPROVED	May 6, 1954			Total amount paid for	
Tractor		Between		Nature	Date of		Damages and Property	r - E
Parcel	Granton	Stations	Area	Title	Taking	Land	Adjustments	Total
	Eastgate Homes Inc.	193 + 00 to 201 + 93	0.4446	Easement	6-22-55	2,000,00	500.00	2,500,00
	Northern Ind. Pub. Serv. Co.	202 + 93 to 204 + 43	0.78	Easement	6-30-53	2,072,00		2,072,00
<b>R</b>	Northern Ind. Pub. Serv. Co.	202 + 93 to 204 + 43	0.15	Easement	12-29-54	300,000		300*00
	Helen C. Gardner	204 + 43 to 4+ 60PR	0.50	Easement	10-15-54	Sec.		Free
20	Victor Kirsch	5+65.5 PR to 60 + 50(SK.2)	3 <b>.</b> 02	Easement	10-26-54	6,500,00		6,500,00
<b>\$9</b>	Charles Storbeck	33 + 42.16 to 35 + 62.3	0.60	Easement	10-26-51	900*006		00,000
6	Lillian M. Cook	34 + 20 to 226 + 00.	3.h1	Easement	11-22-54	15,000,00		15,000,00
	Gustov Zachau	35 + 62.3 to 37 + 82.6	0.61	Easement	11-26-54	00*006		900.00
6	Bertha Anderson	37 + 82.6 to 40 + 02.9	0.61	Easement	11-22-54	00*006		00*006
<b>1</b> 0	George H. Zachau	40 + 02.9 to 10 + 00	0.75	Easement	12-9-54	1,125,00		1,125,00
	Sidney & Louis Pachter	58 + 55 ° 61 + 85	0 <b>.</b> 22	Easement	12-20-54	14,850,00		14,850.00
*12-12A 12-3-120	Jordon R. Brant Inc.	62 + 37.06 to 68 + 46.06	1.289 As paid by	As paid by Court Award		40,470,00	Agreed Judgment	40,470,00
<b>1</b> 3	Sylvia R. Hamm	63 + 14,06 to 63 +39,06	2661 sq. ft.	Easement	10-26-54	1,375.00		1,375,00°
<b>37</b>	lawa Baril	63 + 39.06 to 63 + 64.06	2661 sq. ft.	Easement	12-18-54	1,600,00	•	<b>Ι, έφο</b> τοο
*15	H.C. Gotshall	66 + 70 to 66 + 95	2661 sq. ft. As paid	by Court Award		1,500,00		1,500.00
<b>J</b> 6	Alfred E. Land	66 + 90.06 to 67 + 15.06	2661 sq. ft.	Easement	10-26-54	1,250,00		1,250,00
17	Mercantile National Bank	227 + 49.44 to 5 + 65	80 sq.ft.	Easement	4-4-55	1,200,00		1,200,00
						\$91.912.00	\$500.00	\$92 hu2 00
* Denotes condemna was not	Denotes parcel were settled by condemnation and cost of each item was not stipulated.							
					•		SUMMARY	
	Incidental Costs			· · · · · · · · · · · · · · · · · · ·	Item		Amount	
	Appraiser's Fee	\$600.00			Land Damage ar Property Adj. and Credits	ge and Adj. ts	\$ 92 <u>.00</u>	
	Total	\$600.000			Incidental	l Costs	600.00	-
					Total Pen	Total Permanent E/W Cost	\$ 93.042.00	
					I certify the al necessary for th State Highway De as submitted to are based on wr	certify the above data are correc seessary for the Project has been tate Highway Dept. of Indiana in a s submitted to the Administrator, re based on written justification	re correct: that the Right of Way has been acquired in the name of iana in accordance with procedures strator, and that the prices paid fication in the State files.	ay res id

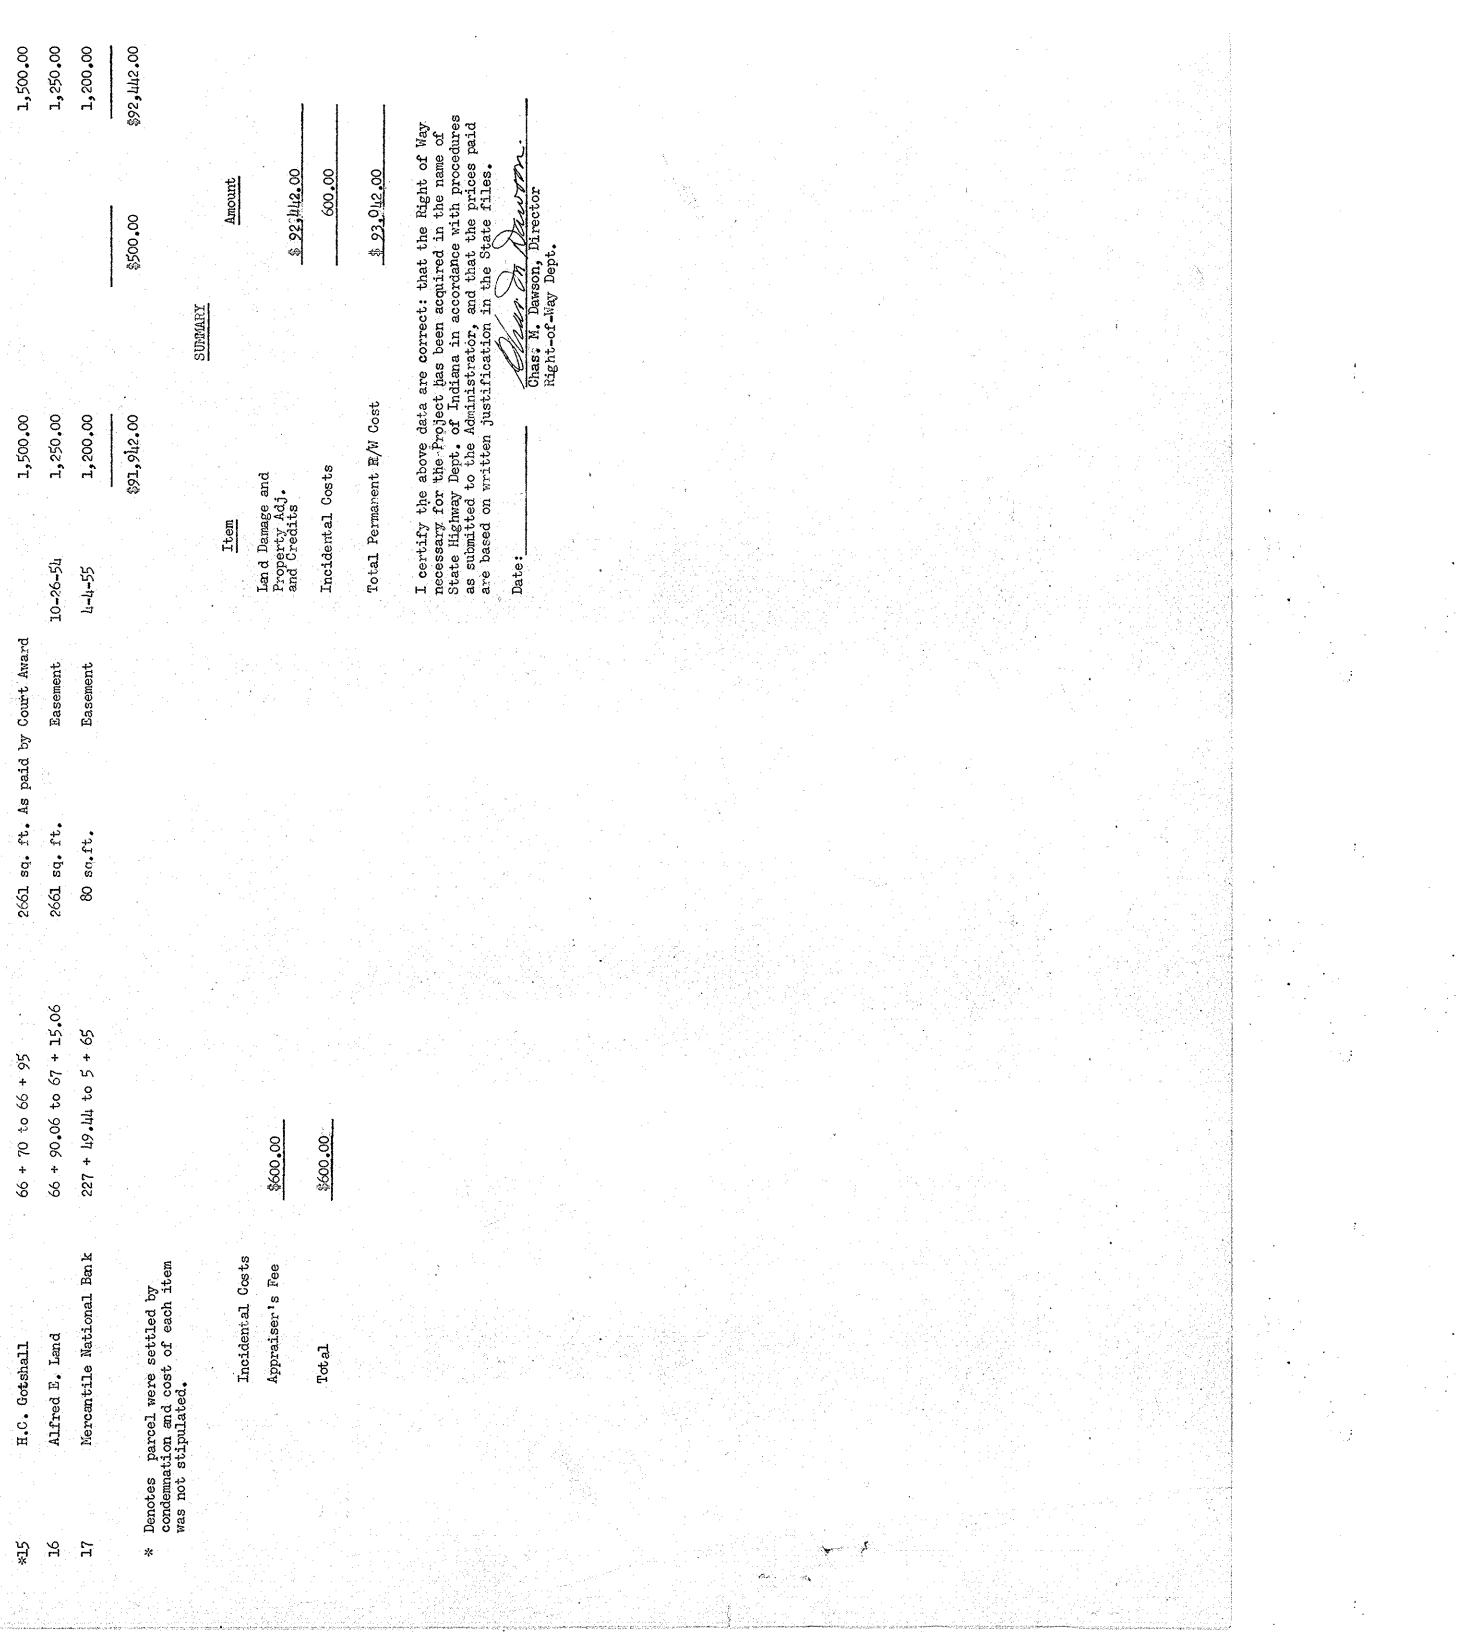


STATE OF INDIANA

CERTIFICATE OF RIGHT-OF WAY COSTS FEDERAL AID PROJECT UI 265 (17)

			Total	2500,00	2072.00	300,00	Free	6500.00	00,000	15000°00	00°006	00°006	1125.00	14850.00	1404.70.00	1375 <b>.</b> 00	1600.00	1500.00	1250.00	1200.00	\$921442.00		20246.000	· · · · · ·	Amount			92942.00	525,000	m Lyne	· ····
	Total amount paid for		Adjustments	500°00											Agreed Judgment						500.00	Ş		Summary				6			<b>70</b>
			Land	2000.00	2072.00	300,000	Free	6500,00	00.000	15000 .00	00*006	00*006	1125.00	14850.00	101170.00	1375,00	1600.00	1500,00	1250,00	1200.00								· · · · · · · · · · · · · · · · · · ·	P		<b>4</b>
UI 265 (17)		Date	oi <u>Taking</u>	6-22-55	63053	12-29-54	10-15-54	10-26-54	10-26-54	11-22-54	11-26-54	11-22-54	12-9-54	12-20 <del>-</del> 54	g.	10-26-54	12-18-54	ård	10-26-54	4-4-55	tal \$91942.00		00. 24XTX TOTOL				1 Damage and Pronenty Ad1	1 Credits	Tneidental Cost	Dominate D Air Con	Total Fermament K/W VOST
	1954	Nature	or title	Easment	Easment	Easment	Easment	Easment	Easment	Easment	Easment	Easment	Easment	Easment	As paid by Court Award	Easment	Easment	ft. As paid by Court Award	Easment	Easment	Total	E	lor			Item	Land	and	ία μ		TOTAL
FEDERAL AII	PROCRAM APPROVED May 6,		Area area area area area area area area	0 <b>.1116</b>	0.78	0,15	0.50	<b>3.02</b>	0. €	<b>3.</b> /J	0,61	0.61	0.75	0.22	1.289 As pair	2661 sq. ft.	2661 sq. ft.	2661 sq. ft. As pa	2661 sq. ft.	80 sq. ft.											
CERTIFICATE OF RIGH		Between	Survey Stations	<b>193+00 201 + 93</b>	202+93 204+43	202+93 204+43	204+43 4+60 PR	5+65.5 Pr 60+50(SK.2)	33+42.16 35+62.3	34+20 226+00	35+62.3 37+82.6	37+82.6 40+02.9	10+02.9 10+00	58+55 61+85	62+37.06 68+46.06	63+14.06 63+39.06	63+39.06 63+64.06	66+70 66+95	66+90 <b>.</b> 06 67+15 <b>.</b> 06	227+49.44 5+65									525.00	525.00	
			Grantor	Eastgate Homes Inc.	Northern Ind Pub. Serv. Co.	Northern Ind. Pub. Serv. Co.	Helen C. Gardner	Victor Kirsch	Charles Storbeck	Lillian M. Cook	Custov Zachan	Bertha Anderson	George H. Zachau	Sidney & Louis Pachter	12-12A 12B-120 Jordon R. Brant Inc.	Sylvia R. Hamm	Laura Baril	H. C. Gotshall	Alfred E. Land	Mercantile National Bank								Incidental Cost	Appraiser's Fee	Total	
		Tract	or Parcel		8	e	<b></b>	ي.	9	6	æ		P	8	12-12A 12B-12	ß	<b>H</b>	Ľ	<b>J</b> 6	71									1		

Form PR-356

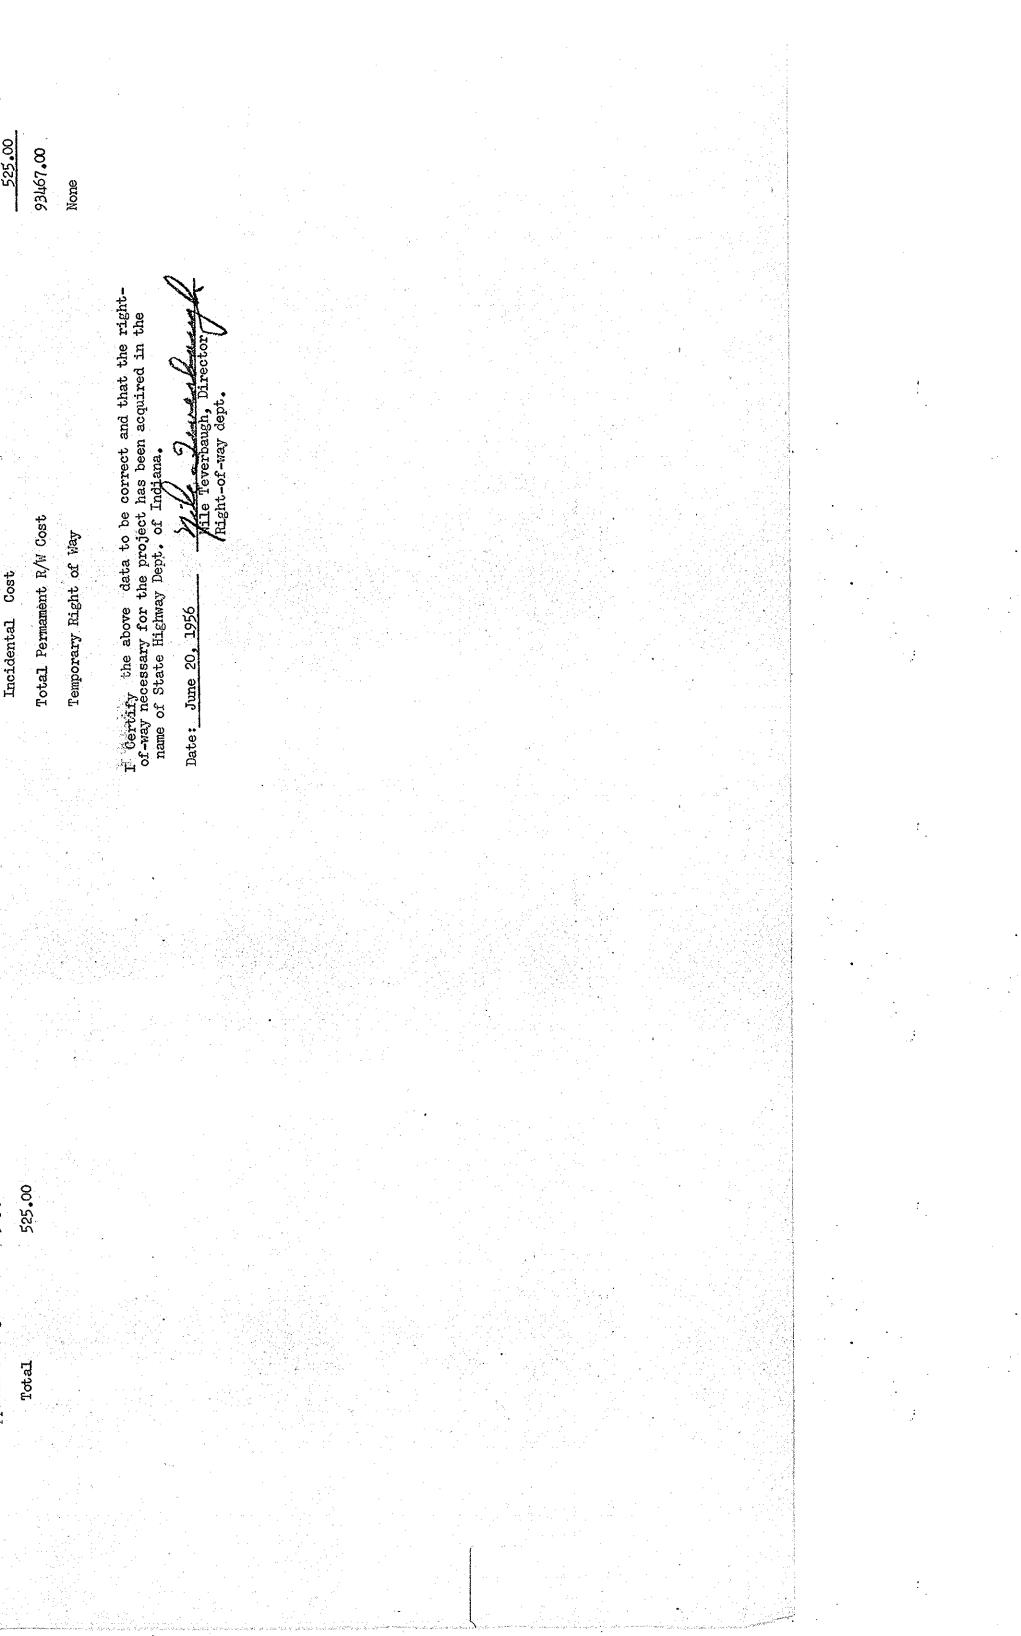

- · · ·		· · · ·	5	
۰.			Total amount paid for Damages and	Property
			paj	ber 1
		۰ ــــــــــــــــــــــــــــــــــــ	÷.	2;
- 1		 	Total amount Damages and	, <b>µ.,</b> .≪
	1 I.		a a a	۱۰۰۰, ۱ ۱
		· · ·	-1 0	0
	÷.	* · · ,	ta. Ma	
			ыq	
				•
-		·		
	1			
				122
·				
		· . <sup>1</sup> • .		
	F			
	S		e de la	
	ã.			. •
	Б		and a second	н У. с. на
· .			an a	
÷.			a	<u>ار الح</u>
	Ē		Date	40
·	မ္မ		6	) (
12 T	ိုင္လ	त्तूं		۰.
	Ë.	ğ	`	
. `	COSTS FEDERAL AID PROJECT UI-265(17)	pproved May 6th, 1954		
	×	्म	đ	) }
	RA	Ľ	Nature	
	DEI	đ	N N	4 C
	E E			1.197
WNWTONT	ഇ	dec.		
Ĩ	ଞ	2		
2	. <b>C</b>	ି ପ୍ରି		انی در بری برسر جران کرد رسم کرد کرد کرد
Ę	IAV	- <b></b>	na sing Na sing	
ר מיי		ra		
IN TINIC	6	00		· · · · ·
10	ΗI	ъ с		
· ·	SIG			5. 15
	E-			
	0	÷		
	Ę			
	Ъ.	·		
	сц Н			
÷	ERTIFICATE OF RIGHT OF 1		1.0	•
	5			÷.,
	1.1		·····	
- :			  	į.

	Total	2,000,00	300.00	Free	6,500,00	900 <b>.</b> 00	15,000,00	00°00	00.000	1,125,00	14,850.00	40,470,00	1,375,00	1,600.00	1,500.00	1, 250.00	1,200.00	89,870.00		<b>4</b>	A FINALINY	89,870.00	600.009	90°170.00	bove data is or the project ghway Dept.	
Total amount paid for Dumance and	Property Adjustments									<b>•••</b>		.00 Agreed Judgment					<b>00</b>					Land Lamage and Froperty adjustments and credits	Incidental Costs	Total Pennanent R/W Cost	I certify from the records on file that the above data is correct and that the right-of-way necessary for the project has been acquired in the name of the State Highway Dept.	
	Land	2,000.00	300.00	Free	6, 500.00	00.006	15,000.00	00*006	00.006	1,125.00	14,850.00	10,170,00	1, 375.00	1,600,00	1,500.00	1,250.00	1,200.00	89,870,00				Land Lamage adjustments	Incider	Total F	I certi correct has bee	of Indiana.
	of Taking	6-22-55	12-29-54	10-15-54	10-26-54	10-26-54	11-22-54	11-26-51	11-22-54	12-9-5L	12-20-54		10-26-54	12-18-54	m	10-26-54	4-4-55							and the second secon		
	nature of <u>Title</u>	Easement	Easement	Easement	Easement	Easement	Easement	Easement	<sup>L</sup> asement	Easement	Easement	peid by Court Award	Easement	Easement	As paid by Court Award	Easement	Easement									
	Årea	0.146 A	0.15 A	<b>8</b> <b>9</b>	<b>3.02</b> A	0,60 A	<b>3. k1</b> A	0.61. A	0.61 A	0.75 A	0.22 A	<b>1.</b> 289 A As pa	2661 SQ.FT.	2661 SQ.FT.	2661 SQ.FT. A	2661 SQ.FT.	æ.									
	between survey stations	193 + 00  to  201 + 93	202 + 93 to 204 + 43	2014 + 143 to 14 + 60 FR	5 + 65.5 PR to 60 + 50 (SK.2)	33 + 42.16 to 35 + 62.3	34 + 20 to 226 + 00	35 * 62.3 to 37 + 82.6	37 + 82.6 to 10 + 0219	10 + 02.9 to 10 + 00	58 + 55 to 61 + 85	62 + 37.06 to 68 + 46.06	63 + 114.06 to 63 + 39.06	63 + 39.06 to 63 + 64.06	66 + 70 to 66 + 95	66 + 90.06 to 67 + 15.06	227 + 19.44 to 5 + 65				<b>00.000</b>	\$600 <b>.</b> 00				
	Grantor	Eastrate Romes Inc.	Northern Ind. Pub. Serv. Co.	Helen C. Gardner	Victor Kirsch	Charles Storbeck	Lillian M. Cook	Gustov Zachau	Bertha Anderson	George H. Zachau	Sidney & Louis Pachter	Jordon R. Brant Inc.	Sylvia R. Hamm.	Laura Baril	H.C. Gotshall	Alfred E. Land	Mercantile National Bank		el were settled by and cost of each item ilated.	Incidental Costs	Appraiser's ree					
	Tract or Barcel				<b>36</b>		le la	<b>60</b>	6	0 <b>T</b>		* 12 - 12A 12-B - 12-C	<b>1</b> 3		۲. *	19 19			* Denotes parcel were condemmation and cos way not stipulated.		Appri					

STATE OF INDIANA

rm PR-356

3-14-

