

	FEDERAL ROAD STATE PROJECT NO. FISCAL SHEET TOT
	REGION NO. STATE PROJECT NO. YEAR NO. SHE 5 IND. ST-875 (A) I I
	DESIGN DATA A.D.T. (1973) 3950 V. P.D.
CODE 1121	A.D.T. (1993) PROJECTED 6700 V.P.D. D.H.V. (1993) 800 V.P.H. DIRECTIONAL DISTRIBUTION None %
	TRUCKS D.H.V. 4 A.D.T. 7 % DESIGN SPEED 50 M.P.H.
같은 가장 사내가 가장 가장 것을 가 같은 것이 것이다. 가장	ACCESS CONTROL Full
n en	
	ILAZAN
	LOCATION OF SECTION INDICATED THUS
	LEGEND
	 A BARRICADE TYPE "A" B BARRICADE TYPE "B"
	C CONSTRUCTION SIGN TYPE "A"
	D CONSTRUCTION IDENTIFICATION SIGN (A) PERMANENT BARRICADE TYPE "A"
	DESIGNED BY
	RECOMMENDED FOR APPROVAL
Ā S S	STANT ENGINEER OF ROAD DESIGN


UTILITIES UTILITY OWNER ADDRESS ELECTRIC PUBLIC SERVICE INDIANA 1000 EAST MAIN ST., PLAINFIELD, IND. 46168 TELEPHONE UNITED TELEPHONE COMPANY OF IND. INC. P.O. BOX 391, WARSAW, IND. 46580 SEWER CITY OF PERU UTILITIES P.O. BOX 67, PERU, IND. 46970 REVISIONS SHEET NO. 2A, 4 \$ 5 DATE REVISED 2-12-76 ADD SP EAGMNT RTG-PARCEL 1. الجي الدراب المتوجين فيرجع فتصفص فالعاد والمراد والرادية We The state of the second النجي الراب المتجري جرج مطعطن فإلغ ويديمهم والراب W W all splat and the second ا يېږې يې دې يېدېک 🕴 خوانۍ د د او د ا MARTIN STALL STALL • -

	GENERAL NOTES Standard divided lane sections for Federal AidProjectsas shown on Sheet No. to be
-+	used on this project. Standard ramp section to be used on this project.
	Standard ramp section to be used on this project. Pavement thickness shall be Standard single lane pavement sectionsas shown on Sheet Noto be used on this project.
	A Pavement shall be used.
*	Typical cross-section as shown on Sheet No. <u>3</u> to be used on this project.
*	Standards under dates as listed in the Index on this Sheet to be used on this project. Grade line as shown on profile represents top of finished surface.
*	All Ditches of 1% grade and over shall be sodded except where ditch is in rock cut or where Paved Side Ditch is to
	De constructed.
	Sodding shall be placed as shown on Standard and Typical Cross-Sections and on Miscellaneous Standard Sheet "MB" All Earth Shoulders, Median Area, Cut, and Fill slopes shall be mulched seeded except where sodding is
*	specified.
	Overhaul and Added Haul Quantities as shown in the Balances are for information only.
	Excavation Quantities as shown include estimated excavation for Public and Private Approaches. See Table on Sheet No. The final Cross-Sections of the "Grading Contract" shall be the original cross-sections of the "Paving Contract" except
	that partial or complete cross-sections shall be taken if necessary to determine the actual quantities of Execution
*	RAMP "A" and RAMP "A" Revare to be cross-sectioned by the Project Engineer before construction. Where existing surface is located outside the Limits of new construction between Sta and Sta
	the contractor will be required to remove the present roadway surface and base as directed by the Engineer
	Quantities for Pipe Culvert Headwalls are based on using Standard Headwalls for retaining 2:1 or 3:1 slopes, and
	Private Drive Headwalls for retaining 4:1 or flatter slopes. For "Kinds of Pipe" permitted for each size and classification as shown on the Structure Data Sheet, see
Ш	Miscellaneous Standard Sheet "MP" & "MP-1"
	Such part of existing downspout drains that are disturbed by replacing the curb shall be replaced and connected as directed by the Engineer Payment for this work shall be included in the Contract with mission for the shall be replaced and connected as
	directed by the Engineer. Payment for this work shall be included in the Contract unit price for Curb."
Ī	The minimum grade for Subsurface Drains shall be 0.20%. Where the profile grade is less than 0.20%, special grades
	for Subsurface Drains shall be established by the Engineer.
+	The Contractor must accept the plan quantities of Subbase as given on the Estimate of Quantities Sheet. County Roadshall have 4 "Edge Lines" and "Skip Center Line" as set out in "Special Provisions" and "Yellow
	Barrier Lines' shall be placed as shown on plans.
	All Limited Access R/W (L.A. R/W) to be fenced with Chain Link Type Fence (C. L.T.F.) as specified in the plans.
	Curves shall be Superelevated according to the Standards of Nov. 1967 (Except Special "Super-Transitions" shall be
1	<u>aetailea on Sheet No. 8.).</u>
+	A Keyway Joint is to be constructed on Median side of each pavement. Contraction Joints shall be placed at all manholes within pavement limits.
1	Contraction Joints shall be placed at the beginning and end of all radii, at street and alley intersections
Ļ	When Guard Rail Type "A" is called for on this project the Contractor shall use the Steel Beam section only
	When Guard Rail Type"B" is called for on this project the Contractor, shall have the option of using either the Steel Beam Section, the Semi Ellipse Aluminum Tubular Section or the Steel Tubular Section.
Ŀ	When Guard Rail Type "C" is called for on this project the Contractor shall have the option of using either the Steel Beam
1	Section, the Semi Ellipse Aluminum Tubular Section or the Steel Tubular Section.
	When Guard Rail Type"D" is called for on this project the Contractor shall have the option of using either the Steel Beam Section, or the Semi Ellipse Aluminum Tubular Section.
	When Guard Rail Type "E" is called for on this project the Contractor shall have the option of vision sittles the option
1	When Guard Rail Type"E" is called for on this project the Contractor shall have the option of using either the Steel Beam Section, the Semi Ellipse Aluminum Tubular Section or the Steel Tubular Section
	When Guard Rail Type "E" is called for on this project the Contractor shall have the option of using either the Steel Beam Section, the Semi Ellipse Aluminum Tubular Section or the Steel Tubular Section. When Guard Rail Type "F" is called for on this project the Contractor shall have the option of using either the Steel Beam
	When Guard Rail Type "E" is called for on this project the Contractor shall have the option of using either the Steel Beam Section, the Semi Ellipse Aluminum Tubular Section or the Steel Tubular Section. When Guard Rail Type "F" is called for on this project the Contractor shall have the option of using either the Steel Beam Section, the Semi Ellipse Aluminum Tubular Section or the Steel Tubular Section. When Guard Rail Type "G" is called for on this project the Contractor shall have the option of using either the Steel Beam When Guard Rail Type "G" is called for on this project the Contractor shall have the option of using
Steel Tubular Section. When Guard Rail Type "G" is called for on this project the Contractor shall have the option of using either, the Semi Ellipse Aluminum Tubular Section or the Steel Tubular Section. When Guard Rail Type "H" is called for on this project the Contractor shall have the option of using either, the Semi Ellipse Aluminum Tubular Section or the Steel Tubular Section. When Guard Rail Type "H" is called for on this project the Contractor shall have the option of using either, the Semi Ellipse Aluminum Tubular Section or the Steel Tubular Section. When ever reference is made, on the design plans to Subbase Type T or T or Subbase Type T, this reference is the here.
	When Guard Rail Type "E" is called for on this project the Contractor shall have the option of using either the Steel Beam Section, the Semi Ellipse Aluminum Tubular Section or the Steel Tubular Section. When Guard Rail Type "F" is called for on this project the Contractor shall have the option of using either the Steel Beam Section, the Semi Ellipse Aluminum Tubular Section or the Steel Tubular Section. When Guard Rail Type "G" is called for on this project the Contractor shall have the option of using either, the Semi Ellipse Aluminum Tubular Section or the Steel Tubular Section. When Guard Rail Type "G" is called for on this project the Contractor shall have the option of using either, the Semi Ellipse Aluminum Tubular Section or the Steel Tubular Section. When Guard Rail Type "H" is called for on this project the Contractor shall have the option of using either, the Semi Ellipse Aluminum Tubular Section or the Steel Tubular Section. When Guard Rail Type "H" is called for on this project the Contractor shall have the option of using either, the Semi Ellipse Aluminum Tubular Section or the Steel Tubular Section. Wherever reference is made, on the design plans to Subbase Type I or II or Subbase Type II, this reference is to be nterpreted as "Subbase" and the materials required will conform to a. "Supplemental Specification for Subbase "
	When Guard Rail Type "E" is called for on this project the Contractor shall have the option of using either the Steel Beam Section, the Semi Ellipse Aluminum Tubular Section or the Steel Tubular Section. When Guard Rail Type "F" is called for on this project the Contractor shall have the option of using either the Steel Beam Section, the Semi Ellipse Aluminum Tubular Section or the Steel Tubular Section. When Guard Rail Type "G" is called for on this project the Contractor shall have the option of using either , the Semi Ellipse Aluminum Tubular Section or the Steel Tubular Section. When Guard Rail Type "G" is called for on this project the Contractor shall have the option of using either , the Semi Ellipse Aluminum Tubular Section or the Steel Tubular Section. When Guard Rail Type "H" is called for on this project the Contractor shall have the option of using either , the Semi Ellipse Aluminum Tubular Section or the Steel Tubular Section. When Guard Rail Type "H" is called for on this project the Contractor shall have the option of using either , the Semi Ellipse Aluminum Tubular Section or the Steel Tubular Section. Wherever reference is made, on the design plans to Subbase Type I or II or Subbase Type II , this reference is to be nterpreted as "Subbase" and the materials required will conform to a, "Supplemental Specification for Subbase". Linear Grading shall consist of all earthwork quantities necessary to construct the Ramp, crossovers, shoulders, and approaches as indicated on the typical section and detail sheets, and all ditch improvements resulting thoreform



















When Guard Section and the steel section the steel Tubular Section. Where we reference is made, on the design plones to Subbase Type I or II or Subbase Type I. Linear Grading shall consist of all earthwork quantilies necessary to construct the Ramp, crossovers, shoulders, and approaches as indicated on the typical section and detail sheets, and all ditch improvements resulting
	When Guard Roll Type'E' is called for on this project the Contractor shall have the option of using either, the Steel Beam eistion, the Semi Ellipse Aluminum Tubular Section or the Steel Tubular Section. therefrom r as required by the Engineer to assure proper drainage. REPRESENTS GENERAL NOTES REQUIRED Image: Section of the Markein transpresect second transpresect second transpresecond transpr
	When Guard Roll Type*E" is called for an this project the Contractor shall have the option of using either the Steel Beam section, the Semi Ellipse Aluminum Tubular Section or the Steel Tubular Section. When Guard Roll Type*E" is called for an this project the Contractor shall have the option of using either the Steel Section or the Steel Tubular Section. When Guard Roll Type*E" is called for an this project the Contractor shall have the option of using either and the materials required will conform to a "Supplemental Specification for Subbase". 

MAY , 1967

INDEX	FEDERAL ROAD REGION NO.STATEPROJECT5IND.ST-87	YEAR NO. SHEE
DESIGNATION	F.H.W.A. APPROVAL	DATE ADOPTED'A'or LATEST REVISION'B
TITLE SHEET INFORMATION SHEET		
ST'D. DIV. LANE () ST'D. DIV. LANE ()		
ST'D. DIV. LANE () ST'D. SINGLE LANE PAVEMENT SECTIONS		
TYPICAL CROSS SECTION	······································	
ST'D. RAMP SECTION		
ST'D CONT. REINF. CONC. PAV'T. SHEET "CRC-A"		
ST'D. CONT. REINF. CONC. PAV T. SHEET "CRC-A" ST'D. CONT. REINF. CONC. PAV'T. SHEET "CRC-B" ST'D. PAVEMENT JOINTS SHEET "A"		
PLAT NO I PLAN AND PROFILE		
DETAILS TABLE OF QUANTITIES		
STRUCTURE DATA	/	
PAVEMENT EDGE PROFILES ESTIMATE OF QUANTITIES	/	
MISCELLANEOUS STANDARDS, SHEET "MA"	9-29-71	R-1-4-71
MISCELLANEOUS STANDARDS, SHEET "MA-1" MISCELLANEOUS STANDARDS, SHEET "MA-2"		
MISCELLANEOUS STANDARDS, SHEET "MB" MISCELLANEOUS STANDARDS, SHEET "MB-1"	*/	R-1-2-74
MISCELLANEOUS STANDARDS, SHEET "MB-2" MISCELLANEOUS STANDARDS, SHEET "MC"	/	
MISCELLANEOUS STANDARDS, SHEET "MC-1" MISCELLANEOUS STANDARDS, SHEET "MD"	/	
MISCELLANEOUS STANDARDS SHEET "MD-1" MISCELLANEOUS STANDARDS, SHEET "MD-2"	Λ	
MISCELLANEOUS STANDARDS, SHEET "MD-3" MISCELLANEOUS STANDARDS, SHEET "ME"		
MISCELLANEOUS STANDARDS, SHEET "ME - I" MISCELLANEOUS STANDARDS, SHEET "ME - 2"		R-1-2-74
MISCELLANEOUS STANDARDS, SHEEN "MG" MISCELLANEOUS STANDARDS, SHEET MH"		
MISCELLANEOUS STANDARDS, SHEET "MH - I" MISCELLANEOUS STANDARDS, SHEET "M"	9-25-73	R-7-2-73
MISCELLANEOUS STANDARDS, SHEET "MITTI"	5-14-73	R-10-2-72
MISCELLANEOUS STANDARDS, SHEET "MJ-N" MISCELLANEOUS STANDARDS, SHEET "MK"		<u>, </u>
MISCELLANEOUS STANDARDS, SHEET "MN" MISCELLANEOUS STANDARDS, SHEET "MP"	5-26-70	R-4-1-70
MISCELLANEOUS STANDARDS, SHEET "MP-I" MISCELLANEOUS STANDARDS, SHEET "MR"	<u>3-12-74</u> <u>4-9-70</u>	R-2-1-74 R-2-2-70
MISCELLANEOUS STANDARDS, SHEET "MS" MISCELLANEOUS STANDARDS, SHEET "MS-1"	*	<u>R-1-2-74</u>
MISCELLANEOUS STANDARDS, SHEET "MT" MISCELLANEOUS STANDARDS, SHEET "MT-1		
MISCELLANEOUS STANDARDS, SHEET "MT IA" MISCELLANEOUS STANDARDS, SHEET "MT IB"		
MISCELLANEOUS STANDARDS, SHEET "MI - 6A" MISCELLANEOUS STANDARDS, SHEET "MI - 6A" MISCELLANEOUS STANDARDS, SHEET "MI - 6B"	······	
MISCELLANEOUS STANDARDS, SHEET MT-68 MISCELLANEOUS STANDARDS, SHEET MT-12" MISCELLANEOUS STANDARDS, SHEET "MV"		
MISCELLANEOUS STANDARDS, SHEET "MV-1"		
MISCELLANEOUS STANDARDS, SHEET "MV-2" MISCELLANEOUS STANDARDS, SHEET "MV-3"		
MISCELLANEOUS STANDARDS, SHEET MV - 4" ST'D. STR. CONN. FOR EXTENSION	7-9-73	A-Sept-72
ST'D. R. C. BOX CULV. ST'D. R. C. BOX CULV. SK. IND & WING DET. SK. ST'D. R. C. DOX CULV. SK. IND & WING DET. SK.		
ST'D. R. C. BOX CULV. SK END & WING DET. SK. ST'D. R. C. CULV. W. O. F		
ST D. R. C. CULV. U. F. ST D. R. C. CULV. W. O. F. SK.		
ST'D. R. C. CULV. U SK. GUARD RAIL SHEET GR-1		
GUARD RAIL SHEET GR-2 GUARD RAIL SHEET GR-3		
STEEL BEAM GOARD RAIL SHEET GR-3 ALUMINUM BEAM GUARD RAIL SHEET GR-3A		
GUARD RAIL SHEET GR-4 ALUMINUM GUARD RAIL DETAILS SHEET GR-5		
STEEL TUBE GUARD RAIL DETAILS SHEET GR-6 GUARD RAIL PIER CONNECTION DETAILS SHEET GR-7		
ST'D. FOR SUPERELEVATION () ST'D. FOR SUPERELEVATION ()		
ST'D DETOUR SIGNS, SHEET I ST'D DETOUR SIGNS, SHEET 2	7-9-73 *	R-4-2-73 R-1-2-74
ST'D DETOUR SIGNS, SHEET 3 ST'D DETOUR SIGNS, SHEET 4	7-9-73 7-9-73	R-4-2-73 R-4-2-73
SP D DETOUR SIGNS, SHEET 5 SPECIAL SIGNS	7-9-73 *	R-4-2-73 R-2-1-73
CONSTRUCTION IDENTIFICATION SIGNS		
ST'D: HEADWALLS		
CROSS SECTIONS		
F.H.W.A. APPROVAL PENDING		

				· .	. : :						
		· · · · ·									
							A CONTRACTOR				τ ·
								• • •			
										•	
						, , ,					
				ġ		• • •					
				BLDG.	ú	BRIDGE PROJECT R/W REQUIRED.					
				В О С	3.312AC	A REP					
				RESIDUE	K (1997)	BR II	E E				
					C D	RTS RTS CF A I	С ОТОН Е				
	· . ·			LAND	QUIRED •682AC	ASMNT F ASMNT F LIMITS LMITS C	TEASEHOLD.				
		· · · · ·	4	8 5 1	ц Ч Ч		Ц Ц				
			04/25/7	NATURE		SP S	REL EA				
	· · · · · · · · · · · · · · · · · · ·			R.N.		NIHTIW /					
			DATE		い 	TELY	GRANT.				
		1 1 1 1	1121		AC	COMPLETELY	ж/ж Ж				
			CODE	TOTAL	ак пр 3. 95 3.		GCIAL				
				ACQUISITION COMMISSION BRIDGE			TAKING . SPECIAL				
				QUISIT MMISSI BRIDGE		PARTIALLY	THE DEE0+				
		• .	ST-875(A)	FOR LAND E HIGHWAY			NCUMB 55 TS				
	-		1	TO %	APPROX STA. 14	14 44 14 44 THE PARCEL BUILDING	HICH ENCUMBER				
			PROJECT	PARCEL LISTING INDIANA STATE ER FROM TO	~ ~ ×	10 10 5 A BI	ALL				
	(<u>)</u>		,	EL L FRO	APPROX STA. 7	I ICATE CATES	E P E C I				
				PARC IN TER	LINE RAMP A	EAMP A 10 RAMP A 10 E COLUMN INDICATES A COLUMN INDICATES A	DF PRIVATE EASEMENT W FOR CLEARING SPECIAL				
				PAI	いったい さんしょうしん	RA RA DL UMN	IV AT E				
					ASSOC. INC.	ະ ວີວີ ພູ	F C F C F C F C F C F C F C F C F C F C				
	• •		IAMI		ssoc.	BR IDGE BLDG. (
			COUNT Y-MIAMI	TOR		日日	EASMNT RTS = CLEARANCE SP = SPECIAL INSTRUMENT FS = FEE SIMPLE TITLE	regarden i son			· · · ·
		на 1947 г. – С			ER A	jund jund					
			R DAD USR	AL10 ARCEL	NUMBER	IA IB IB IAST IAST	S MNT S				
						* *	щŅЕ				
						<i>K88</i>					
						90 90					
						Ś					
f					

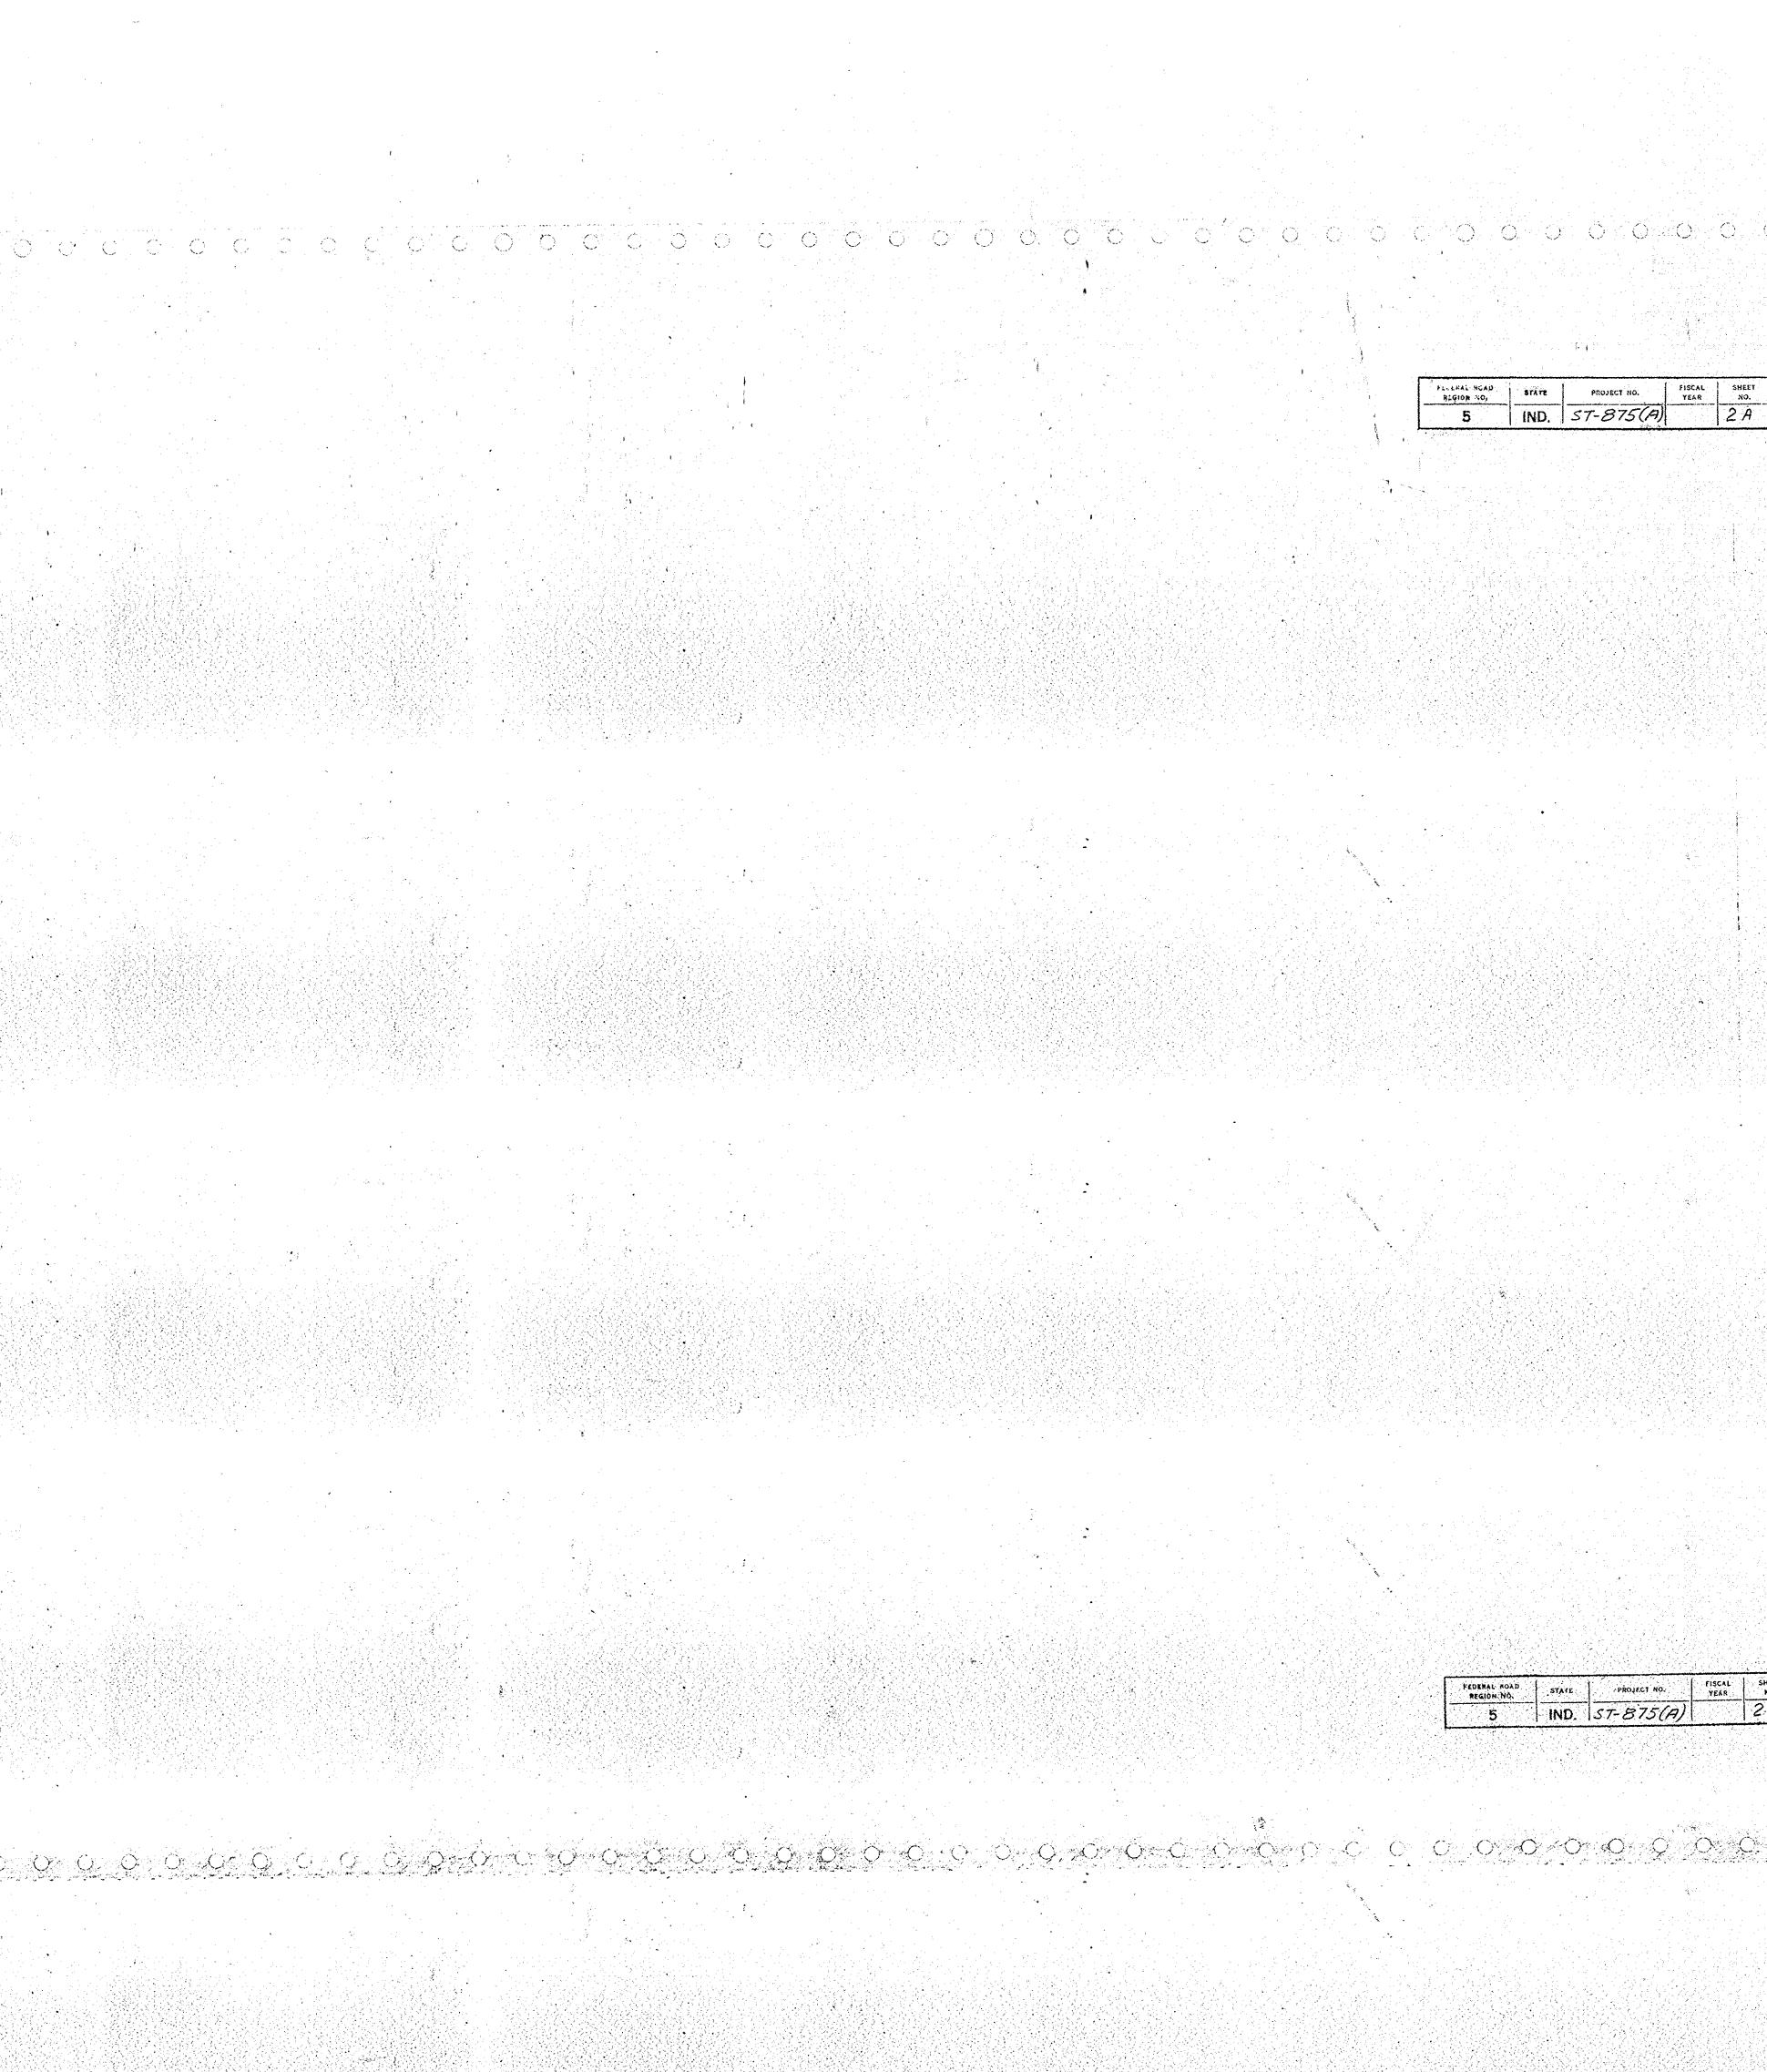


FLEERAL HEAD REGION NO. FISCAL TOTAL SHEET PROJECT NO.

0 C

	5	IND.	ST-875(A)	2 A	
•					1

1															ليني بد مرجع					
ſ	1		NOX NO		1	STA	E	1	P	ROJE	CT N	х.		FISC	. A. S. S. S. S.		SHEE NO.	100	TOT/	n TS
		5				INC)	5	7-	8	75	(A)	7			2	?.A			
ļ	<u></u>	5. 19		*****						1 7. Cr			÷	- S - E	<u> </u>		<u>بني دي م</u>			

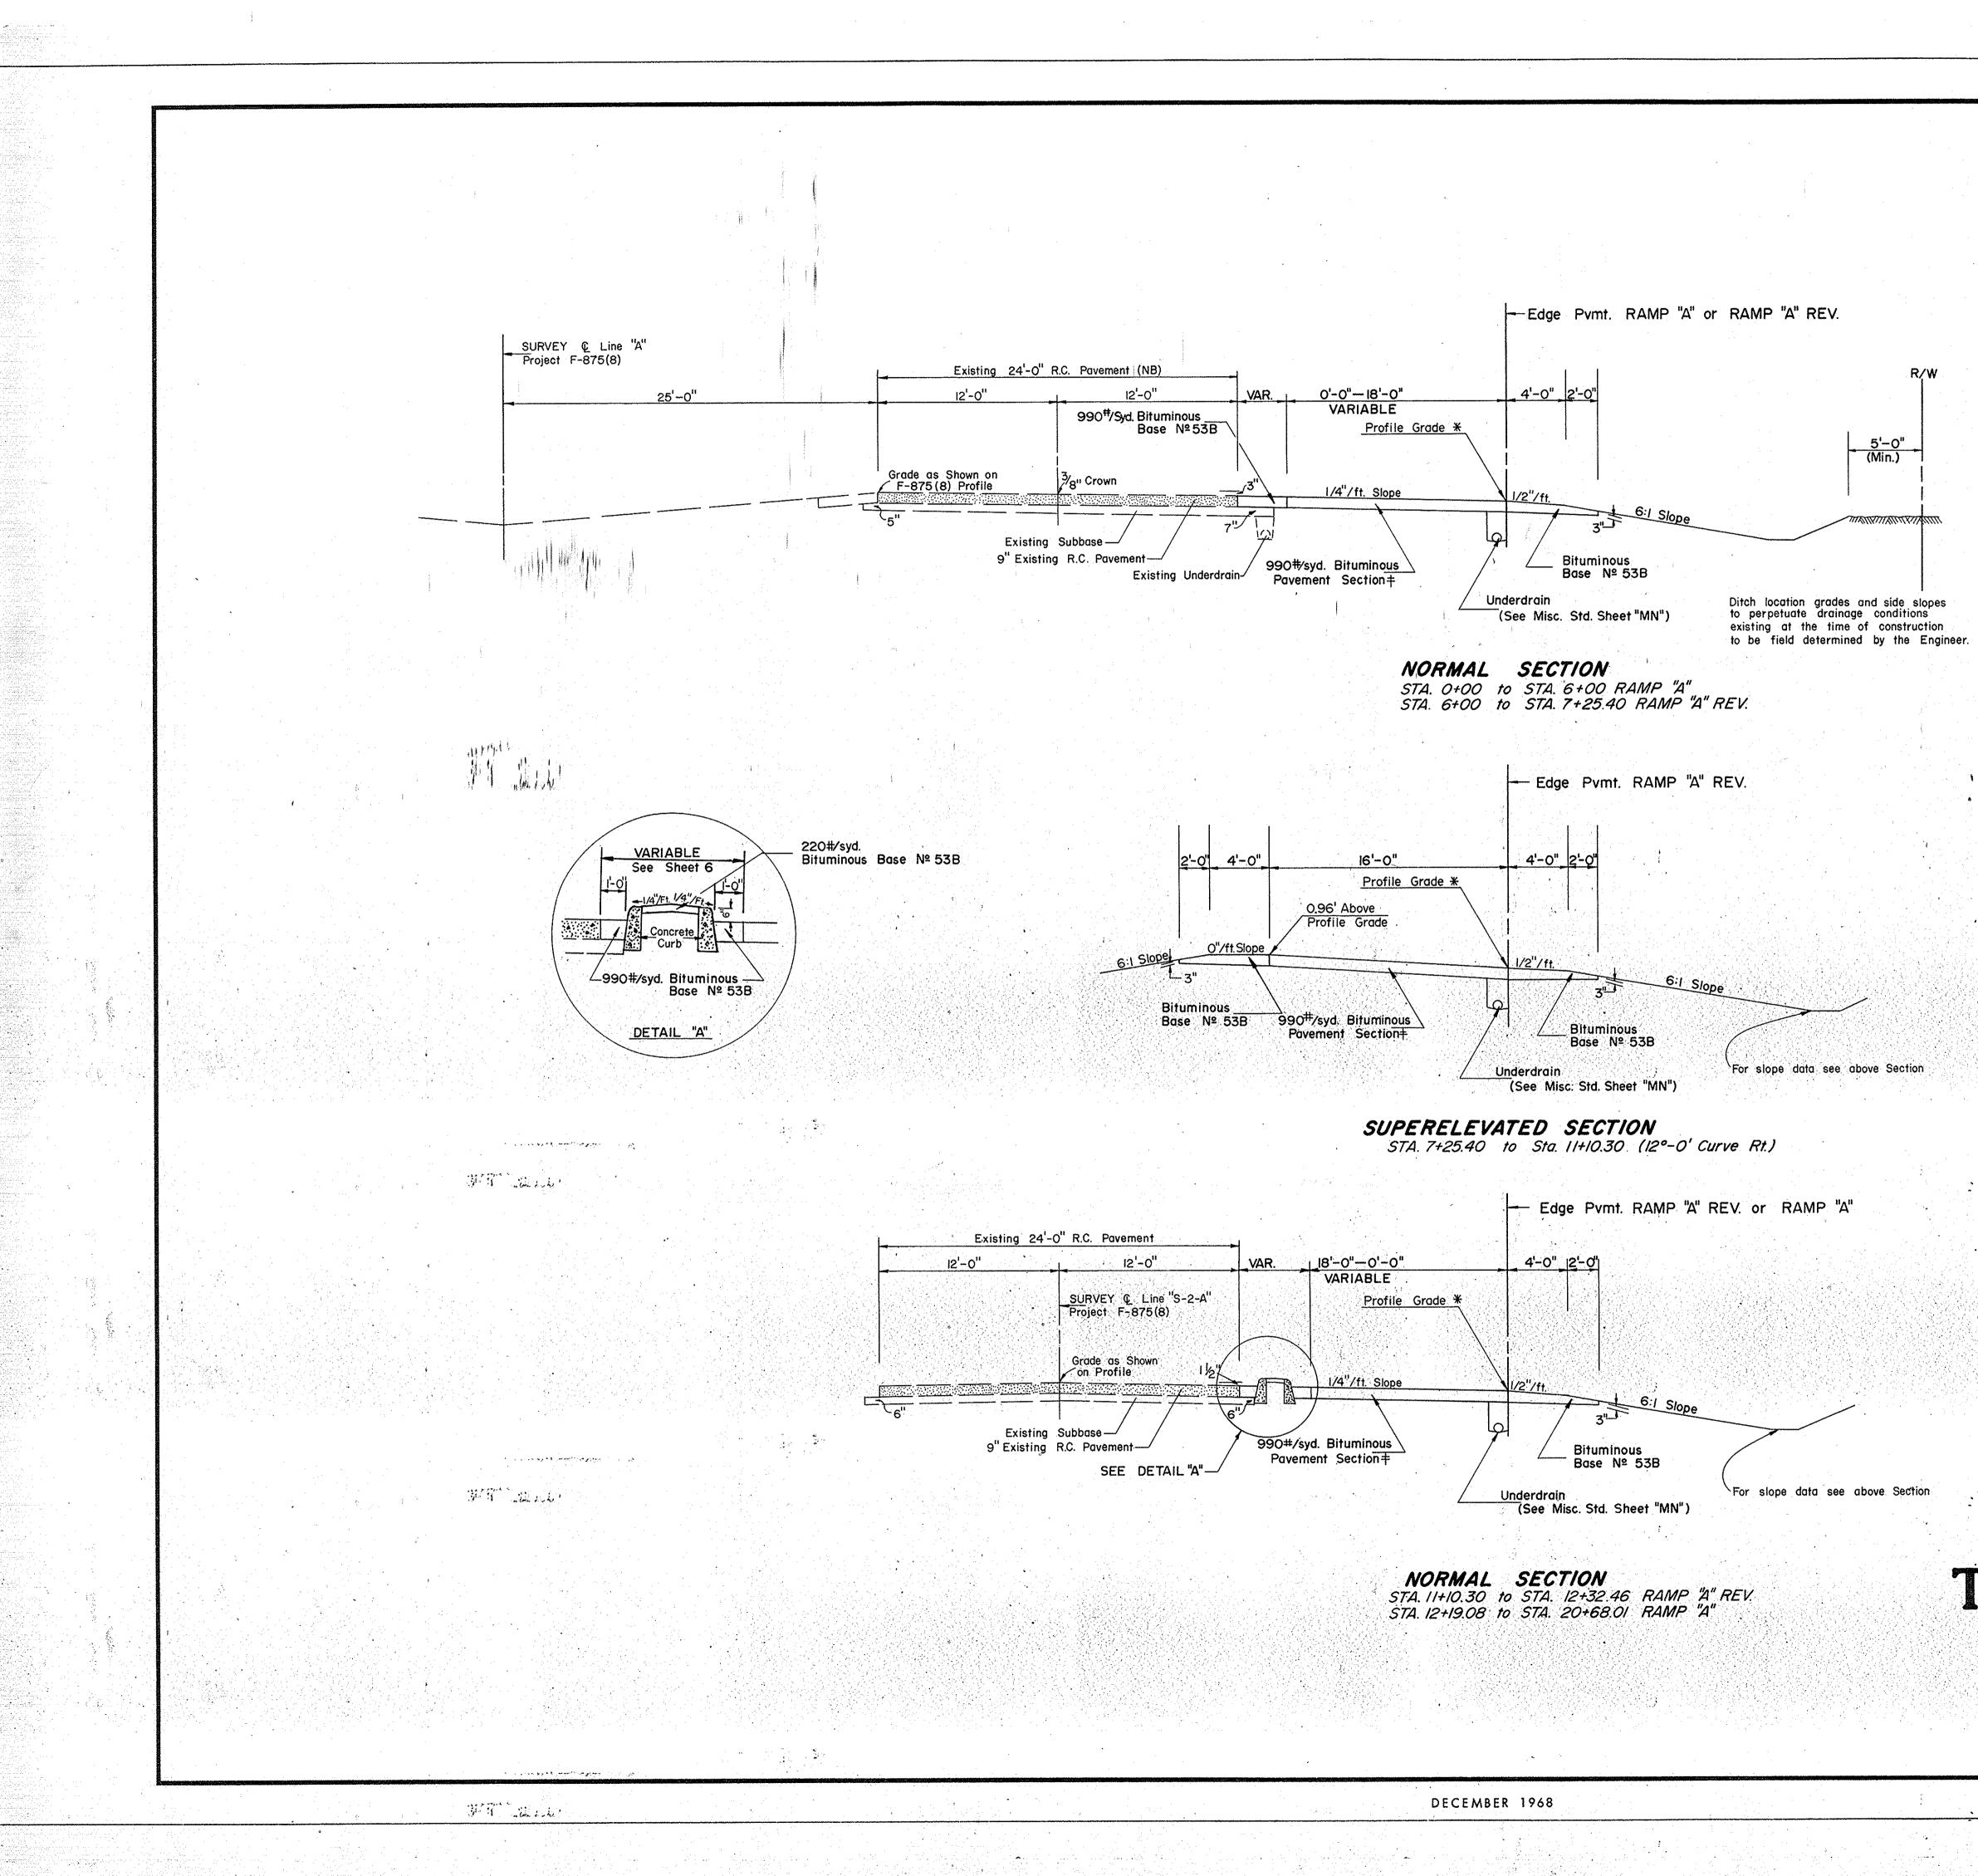



	FEDERAL ROAD REGION NO. 5	STATE				
	}	l			ana ania	
	5		PROJECT NO.	FISCAL YEAR	SHEET NO.	TOTAL
		IND. S	ST-875(A)		3	**
	··· ·					a Artista Artista Artista
		· · ·	•	· · ·	· · · · · · · · · · · · · · · · · · ·	
	• •					
	•		•			
* For Pavement Edge Profiles, see Shee	et 8					
	a an					
<u> </u>				a A Aliana Aliana Aliana Aliana		
1/2"/ft	6:1 Slope	en an de la constant Ser an de la constant Ser an de la constant Ser an de la constant				
9" Existing R.C. Pavement Bituminous	Siope			ing an		
Base Nº 53B			alian an Santa ang barang Barang barang barang	na tan <u>ing</u> Kangada Kana Sata		
	BITUMINC on Detail	DUS PAVE	ALTER			<u>sted</u>
	90 [#] /SY. H 240 [#] /SY. H 660 [#] /SY. H	ot Asphaltic		Binder c	Type "B" n	on
	90 [#] /S.Y. H 240 [#] /S.Y. H 660 [#] /S.Y. H	lot Asphaltic	c Emulsion c Emulsion c Emulsion	Binder o	Type III. M	on
	<u>R BITUMINO</u> on Detail		ROACHES	Desig	nated	-
	110 [#] /S.Y. H 220 [#] /S.Y. H	lot Asphalti lot Asphalti	c Concrete c Concrete ed Aggregat	Base	n	" on
	IIO [#] /SY.H 220 [#] /SY.H 3"Type"F	lot Asphalti	r c Emulsion c Emulsion	Surface Base o	Туре Ш n	I on
		compact	su Ayyısyur			


LINE SHEET TOTAL NO. SHEETS

FILE

PROJECT NO. ST-875(A)

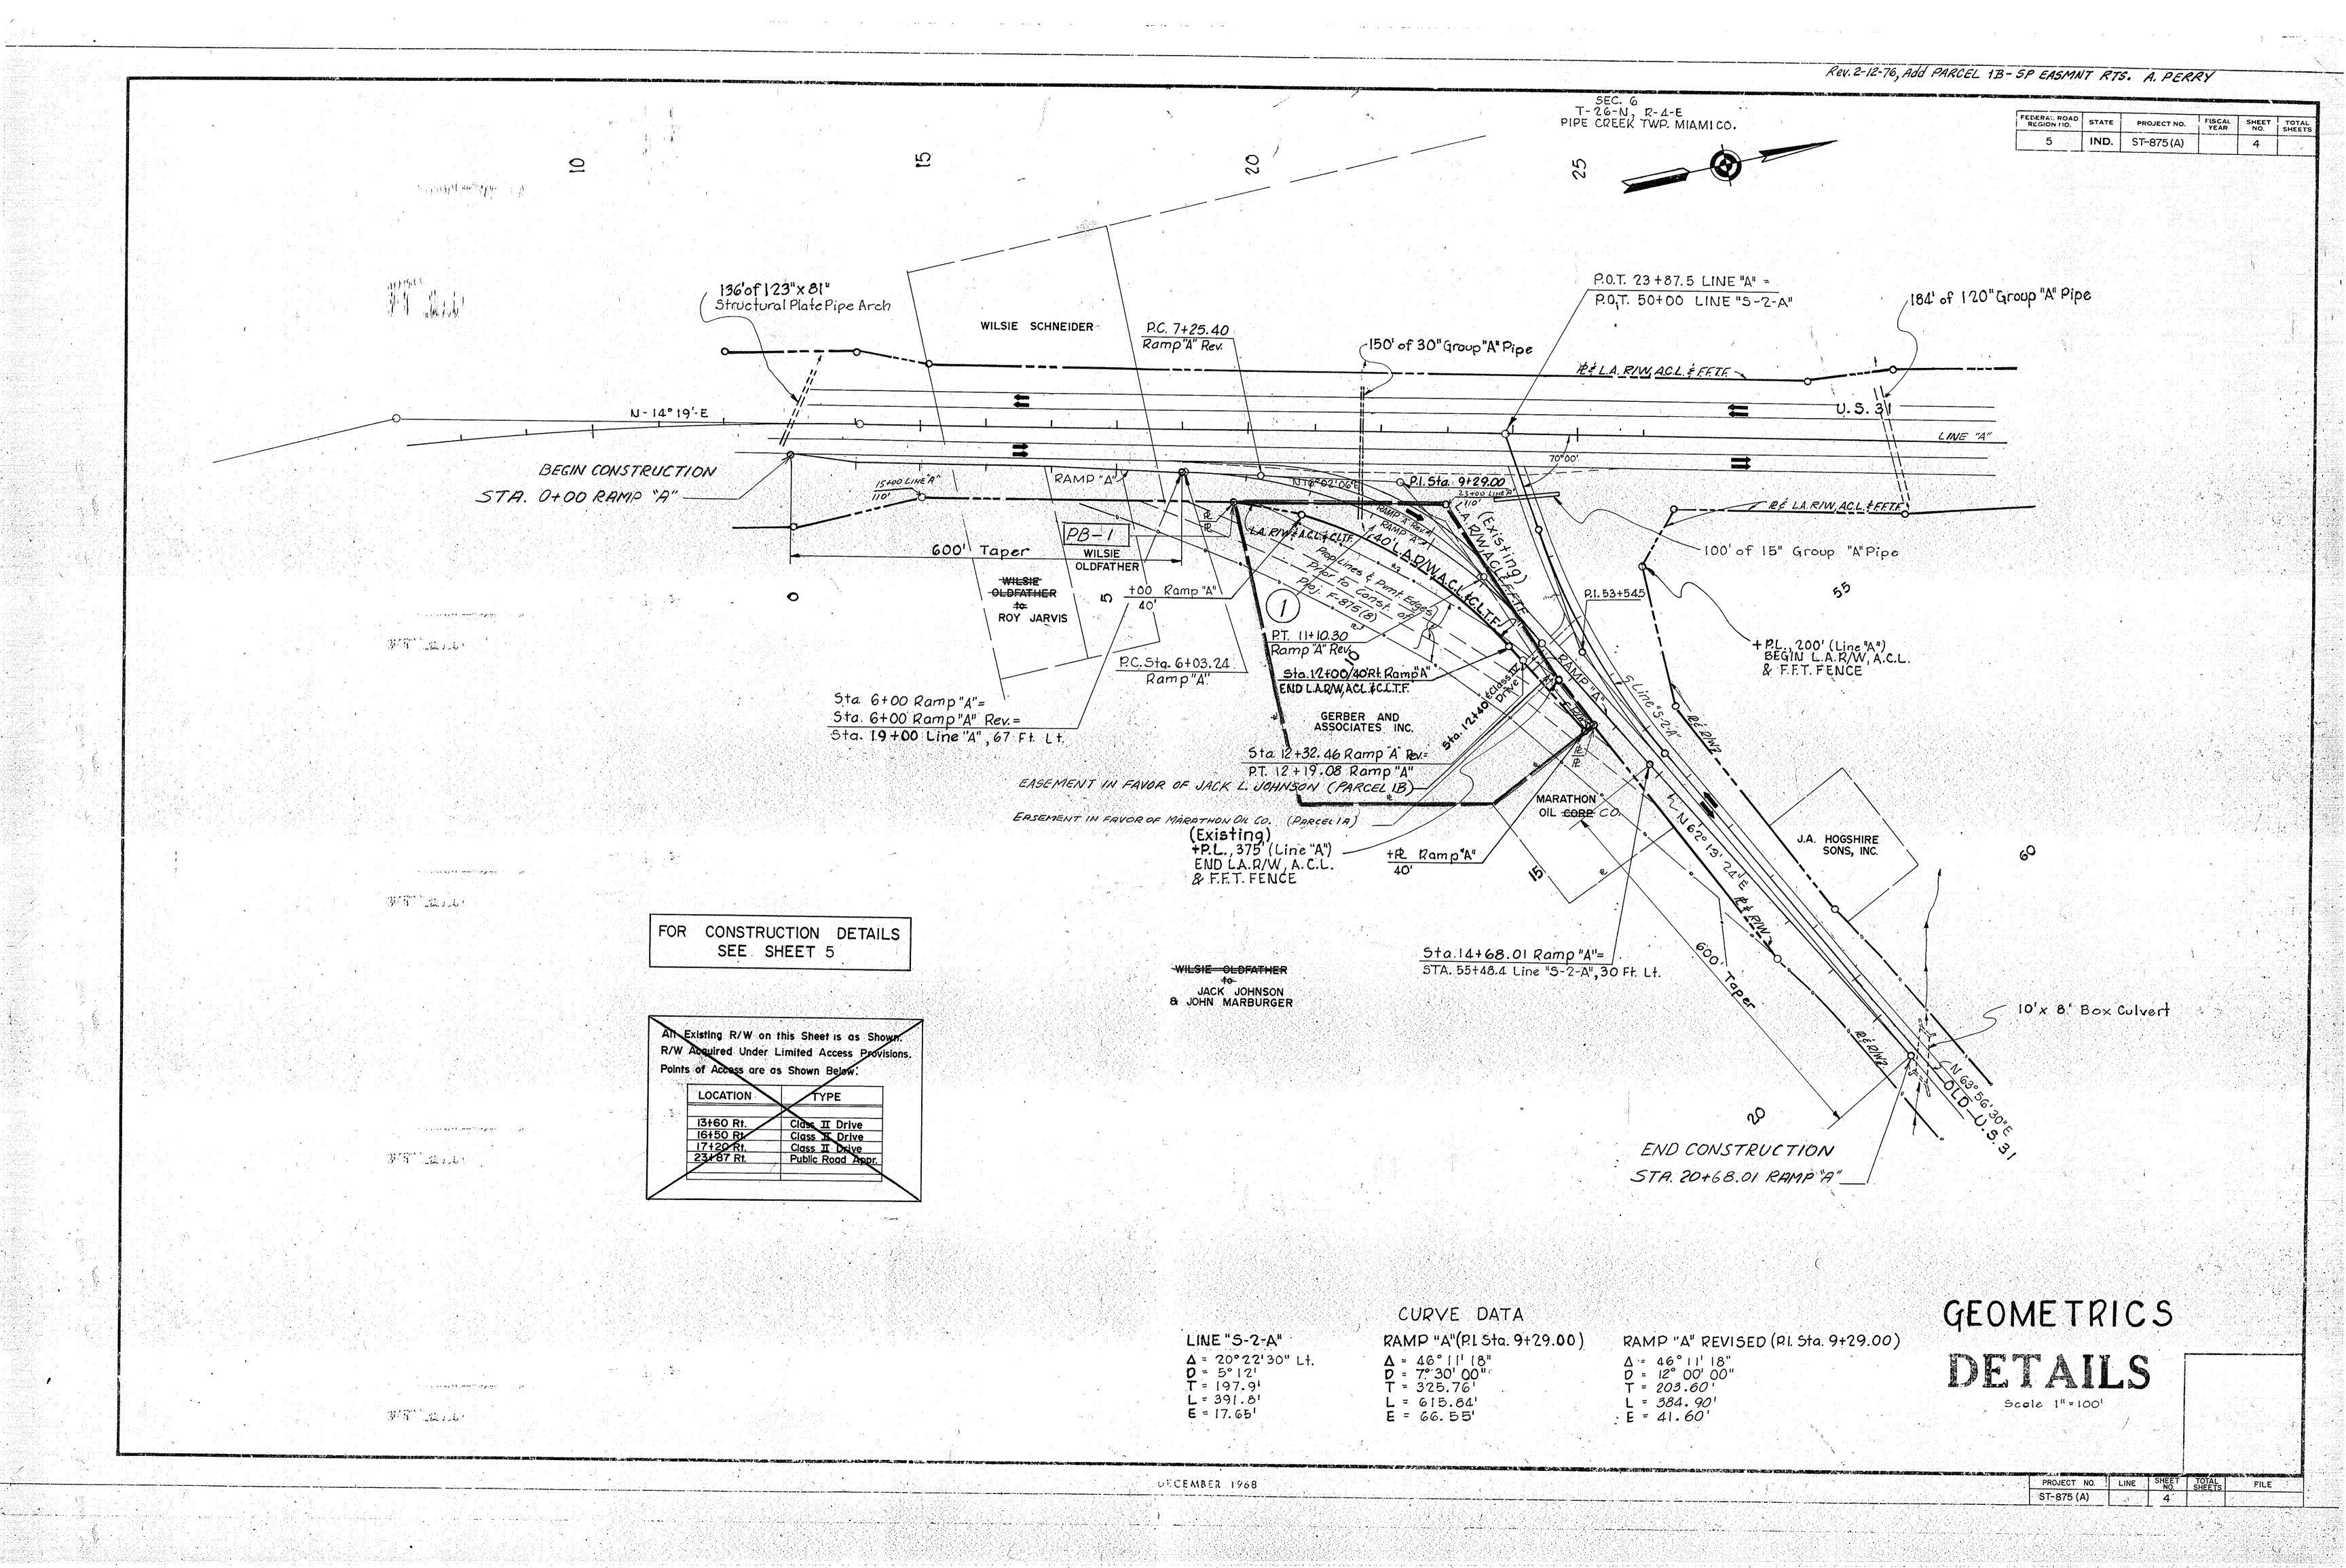

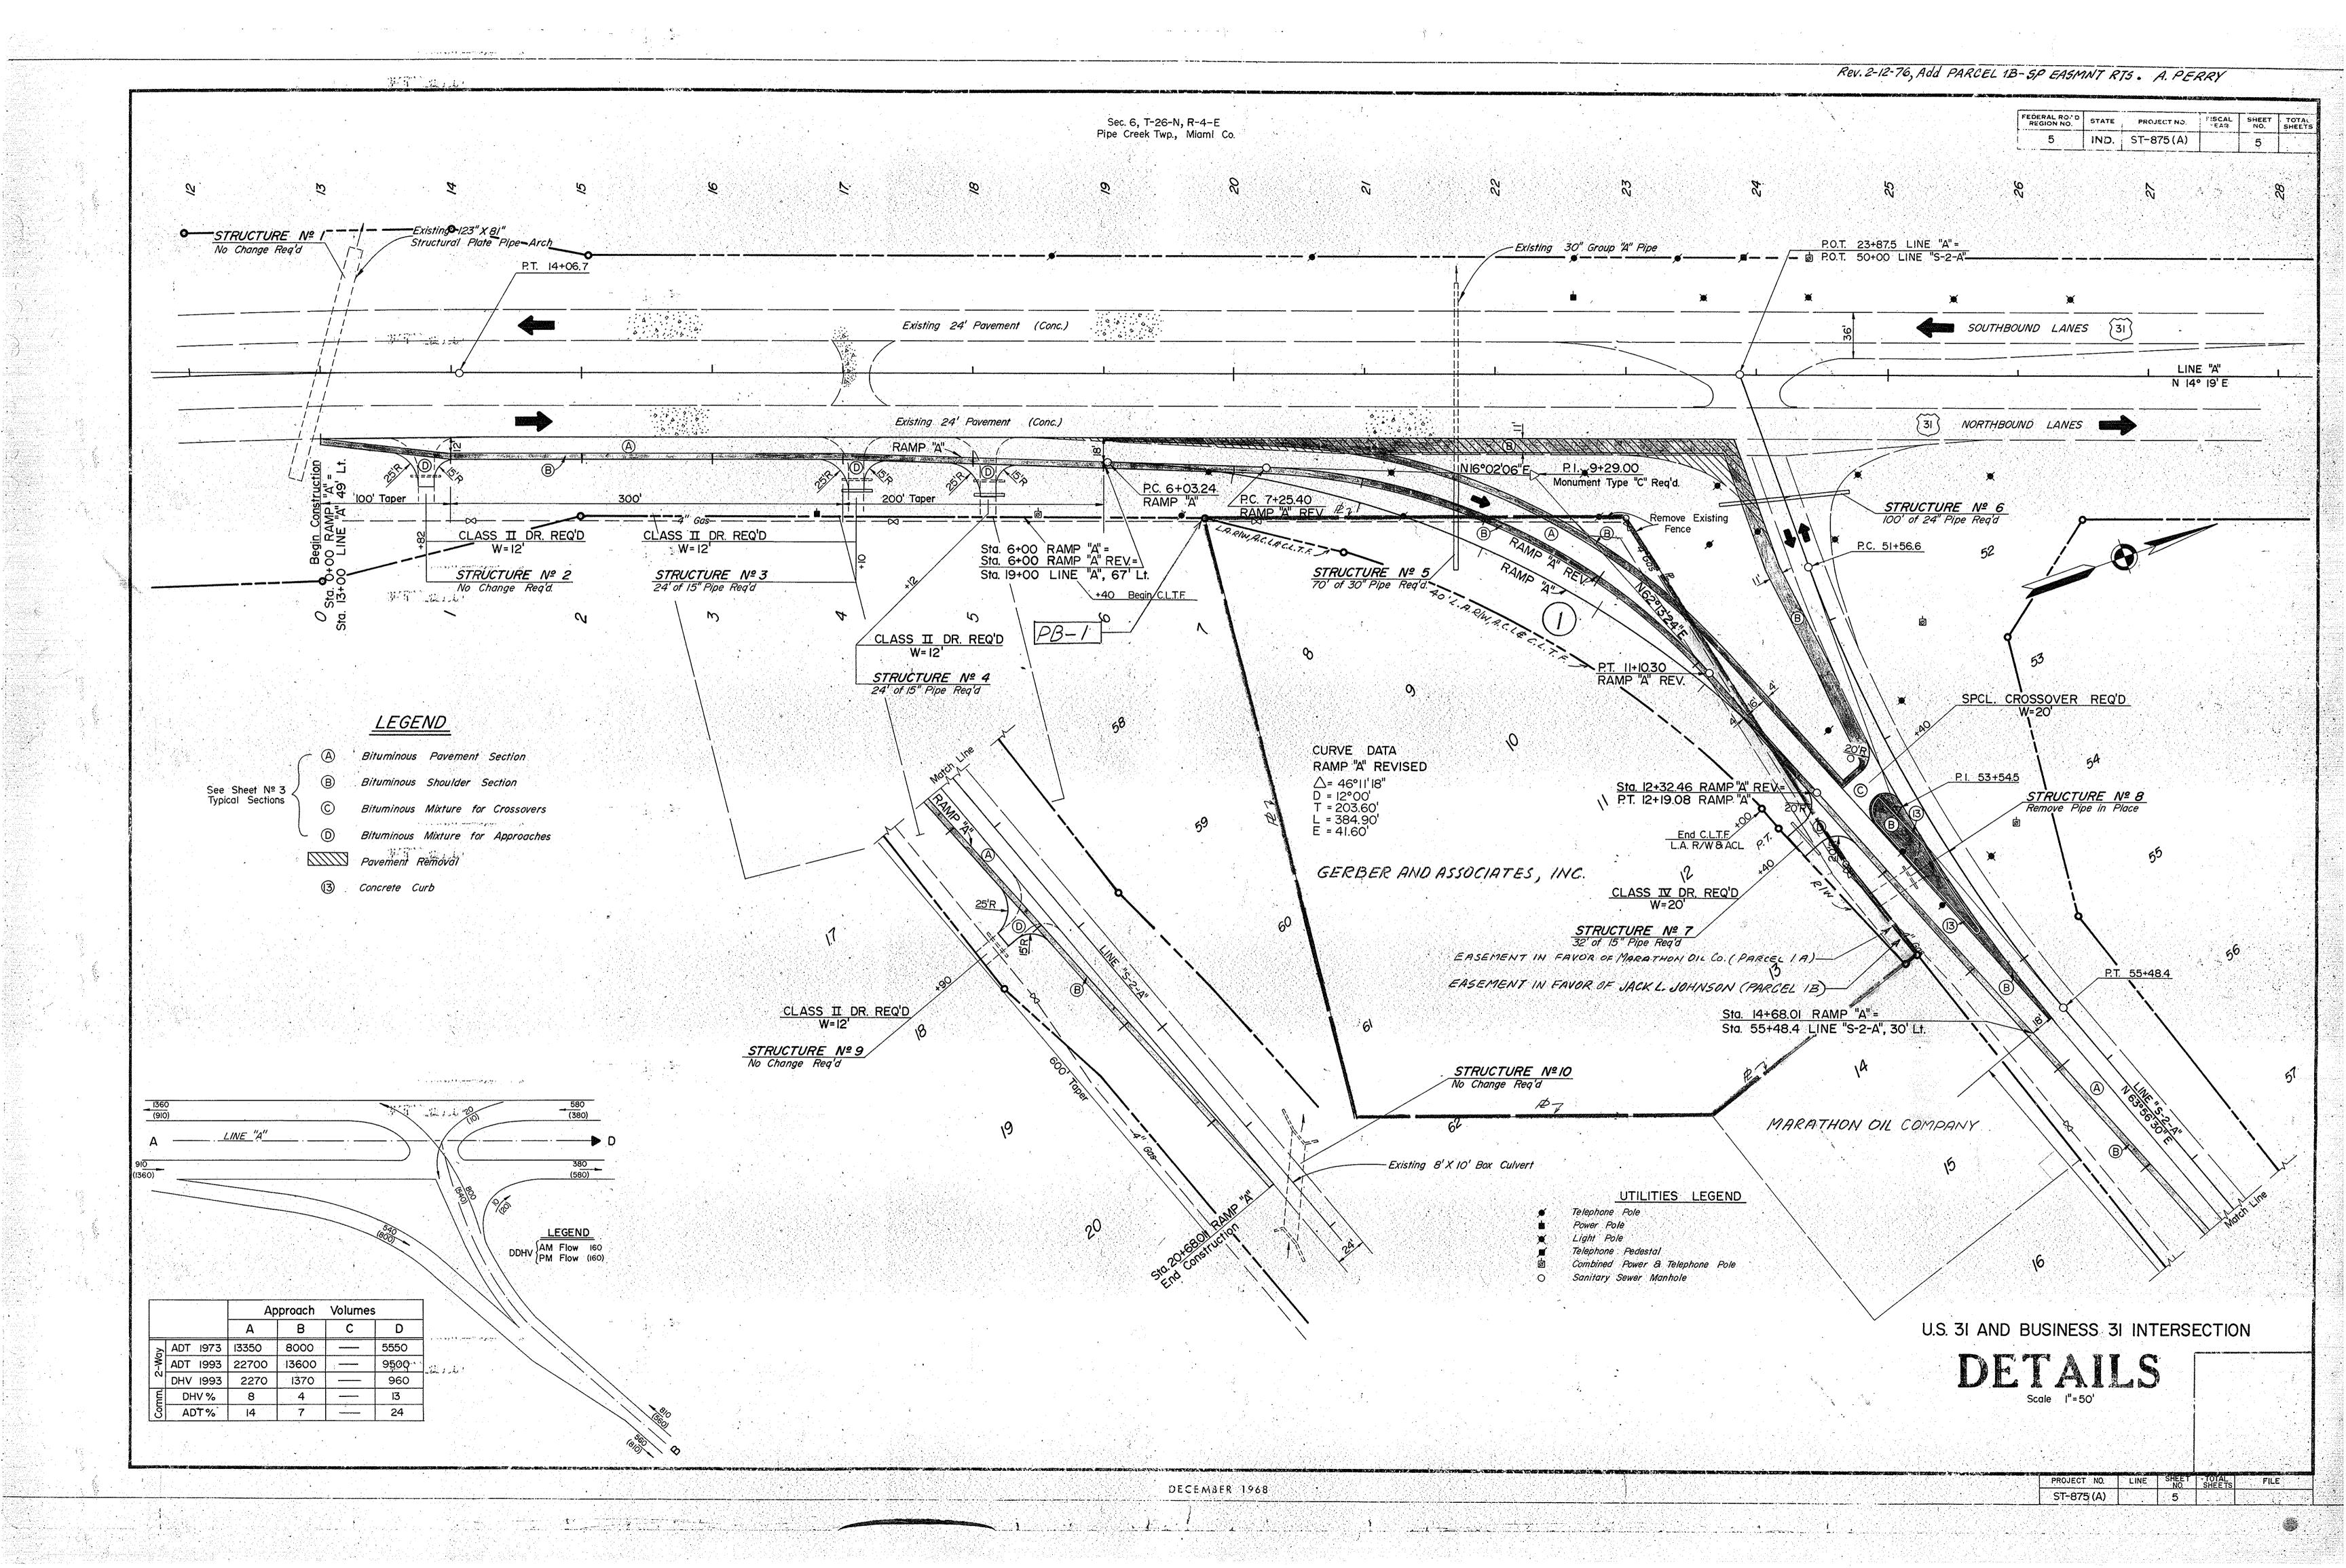

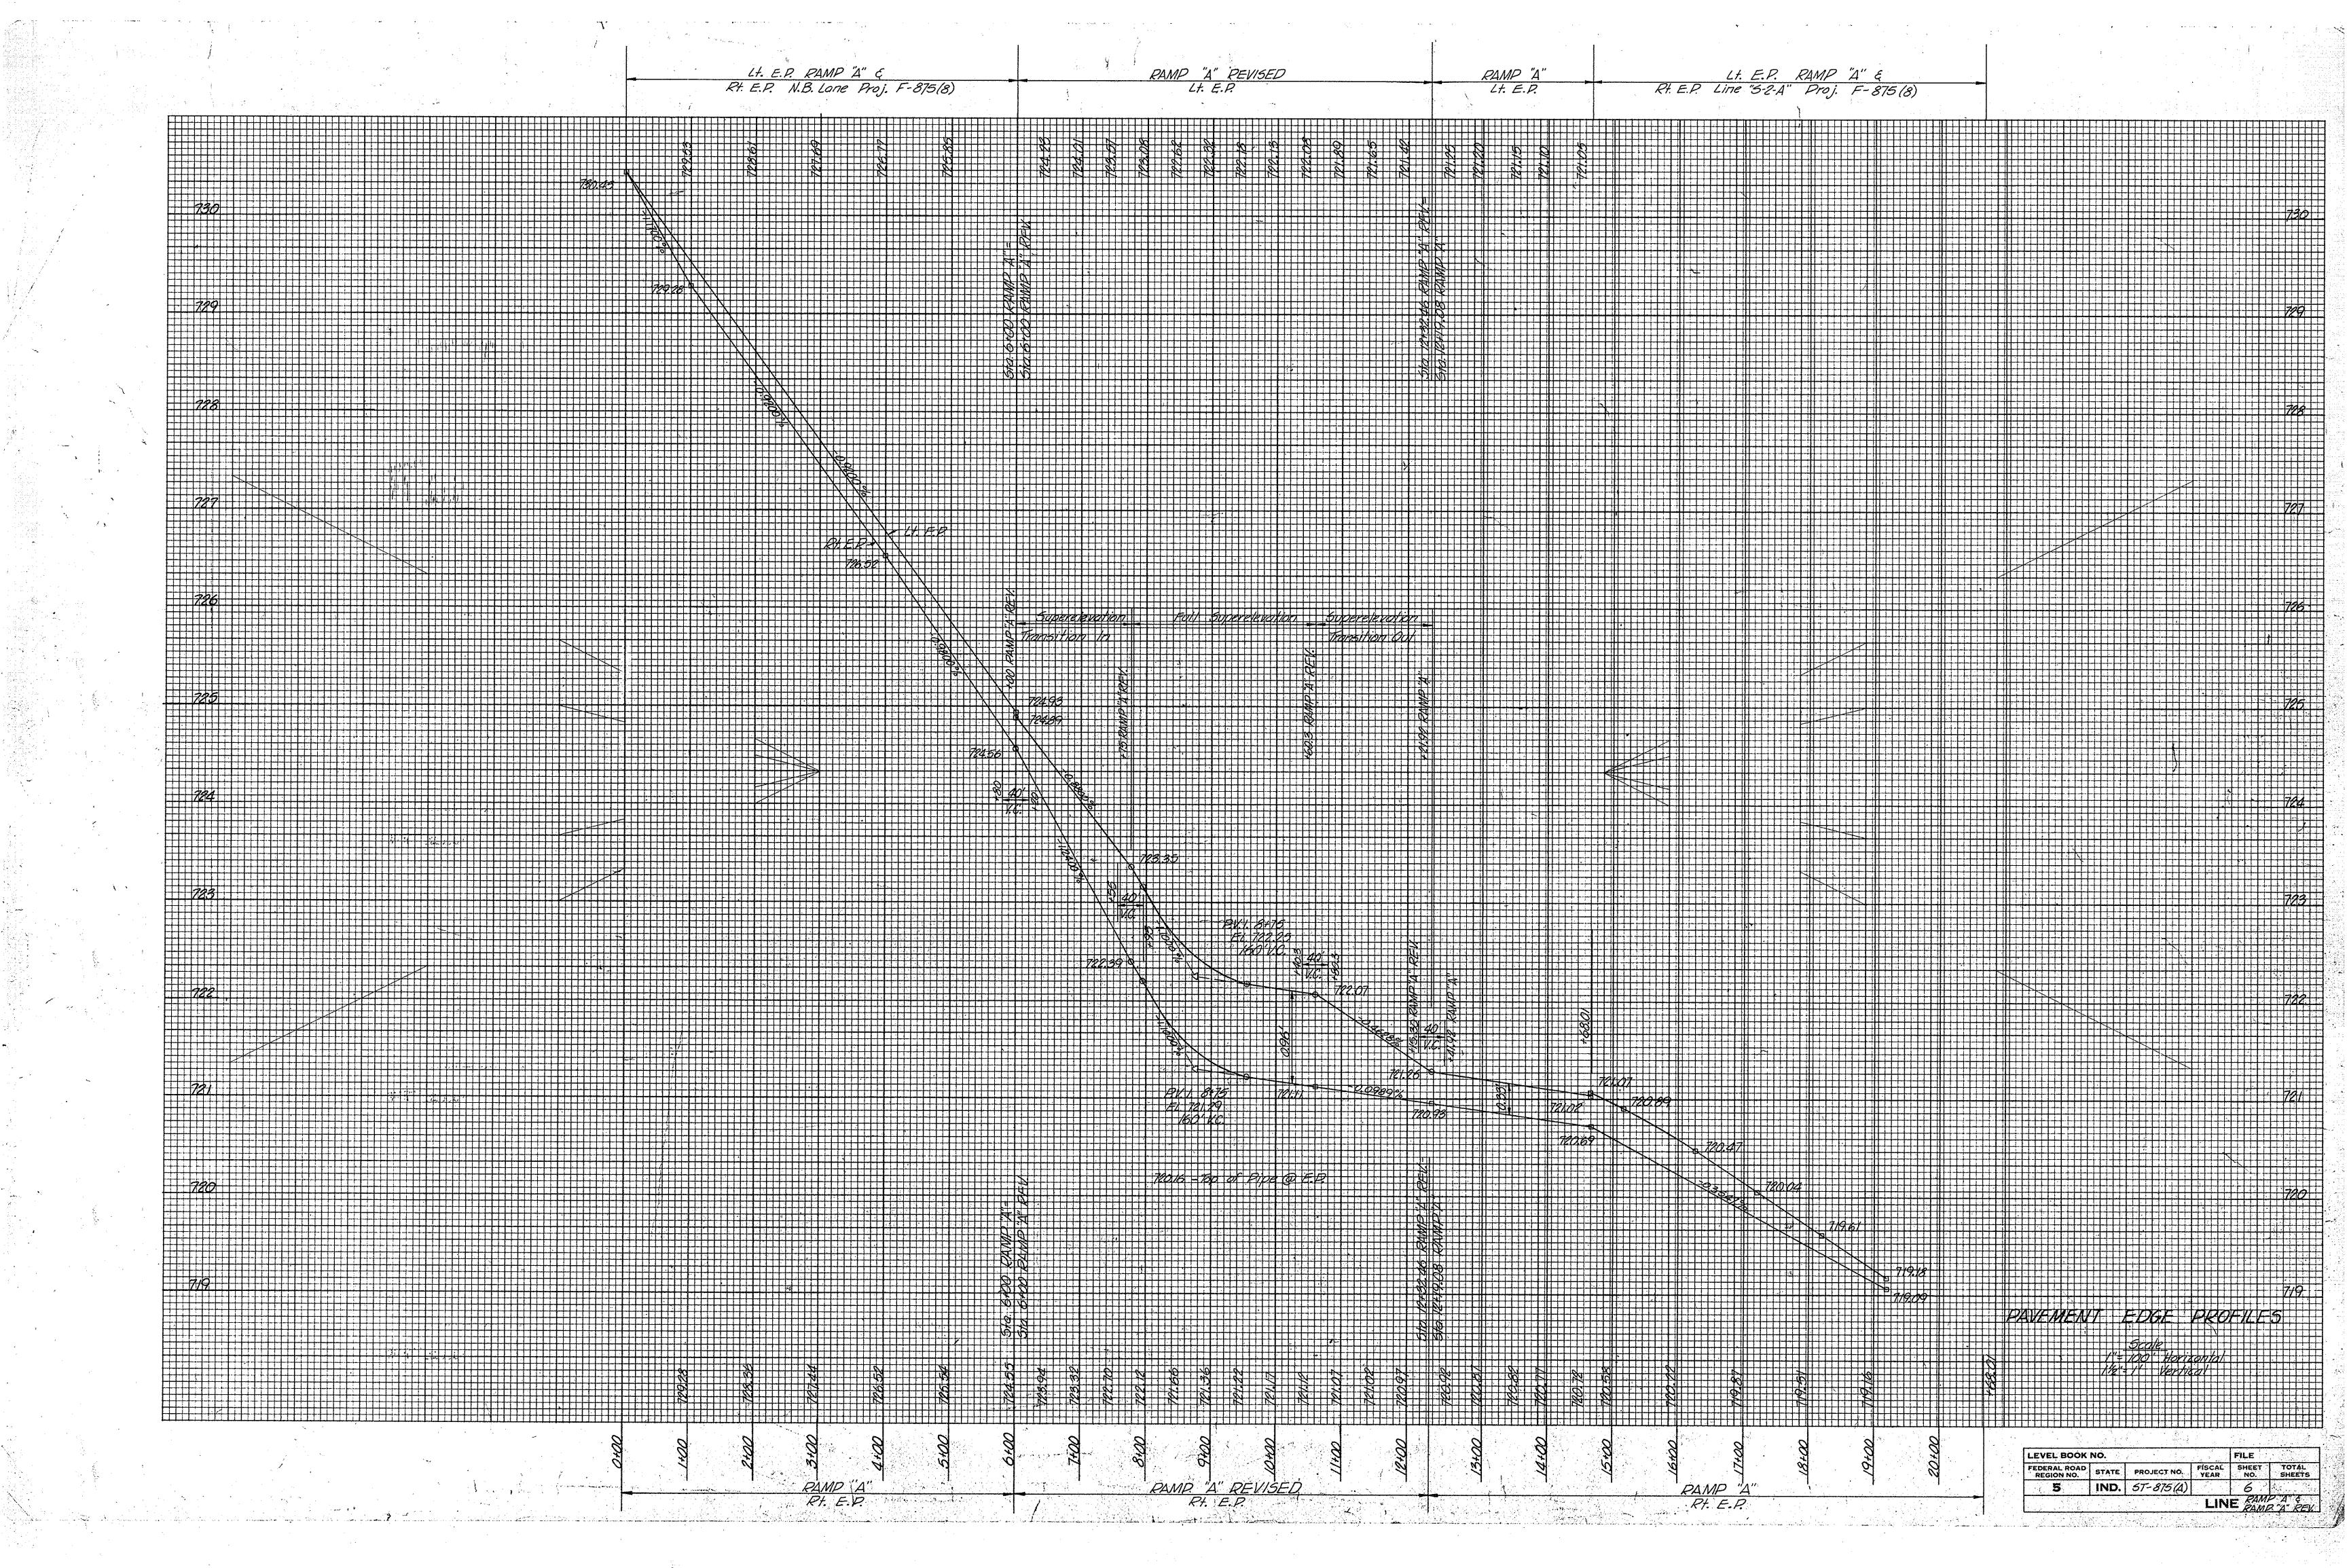

+ Reconstruct Drive as Constructed Under F-Project 875(8) as Indicated on Ft. Wayne District "As-Built" Plans

			1	1	- H and April		· · · · · · · · · · · · · · · · · · ·		1			7	UM		AR	Y	OF	QI	JA	ΝΊ	TIT				1			AC		TA.	B
	LOCATION (STATION)	DESCRIPTION (APPROACH TYPE OR CLASS)	WIDTH	LENGTH	STANCE EYOND W LINE	RADII	GRAD LESST 10% N SHOW	DE THAN JOT VN)	EXCAV	NOITAN	150%		MA FOR BASE	UMINO ATERIA ROAD	S BINDER	BINDER	CRO	UMINOL URE FO	0r 75	BITUMINOUS BASE # 53B	COVER AGGREGATE #12	BITI MATE COAT	UMINOI	TACK COAT COAT	· /	TYP COMPA AGGREGI BAS NO.	ATE FOR		COMPA AGGRE FO SURF	EGATE DR FACE	CALCIUM
	(SIATION)	CLASS)								YS.	330#	_90#	660 #		240 #		<u>990</u> # SYS.	.PER S	the second s				<u> </u>	y e		8"			NO.		
			FEET		FEET	FEET	%	%	CUT	FILL	SYS.	SYS.	SYS.	SYS.	SYS.	SYS.	SYS.	SYS.	SYS.	TONS	TONS	TONS	SYS.	SYS.	SYS.	SYS.	SYS.	SYS.	SYS.	SYS.	TC
	0+82 (Rt.)	CLASS II DR.†	12	23	<u></u>	25,15			· · · ·		51				······································								51	2 	51						<u> </u>
	4+10 (Rt.)	CLASS II DR.+	- 12	25		25,15					54				· · · · · · · · ·								54	·	54						
	5+12 (Rt.)	CLASS II DR. *	- 12	25		25,15				······································	54											· · · · · · · · · · · · · · · · · · ·	54		54						<u> </u>
	12+40 (Rt.)	CLASS IV DR.	20	35		20,20					97	1			· · · · ·								97		· · · · · · · · · · · · · · · · · · ·	97					
		SPCL. X-OVER	· · ·	30		15,20				·				·			87					· · · · · · · · · · · · · · · · · · ·	87					-	······································		
	17+90 (Rt.)	CLASS II DR. 7	12	25		25,15					54												54		54		4				2
		· · · · · · · · · · · · · · · · · · ·						•																							
		<u> </u>												·																	
	0+00.00 to 6+00.00	RAMP "A"	0-10	600			- 28					000	800		000																
	6+00.00 to 12+32.46	RAMP A REV.	0-18 16	632.46				•				800	1125		800 1125					154 608											
	12+19.08 to 14+68.01	RAMP "A"		248.93	•			· · · · · · · · · · · · · · · · · · ·				443	443		443					153			2968	2968							
		RAMP "A"	18-0									600	600		600					154									•		
	UNDISTRIBUTED								2							· ·				104	· · · · · · · · · · · · · · · · · · ·										



	2		· • • ·					FEDERAL RC REGION N				FISCAL YE AR		TOTAL SHE ETS
· .		ili pinato to cinto a trar	<u></u>					5	IND	· ST-87	'5(A)	<u>.</u>	7	
	£	5						· · · · · ·			· · ·	· · ·		
μ	Щ	"CONTINUOUSLY REINF. CEMENT CONC. PAVEMENT		SUC SUC SUC SUC	£.1	j,		S BEYOI	URFACI	e Line	- - 	AGGREGATE FOR UNDERDRAIN	UNDERDRAIN 6"	
CHLORIDE	cover Aggregate		REINF. CEMENT CONC. PAVEMENT	BITUMINOUS STABILIZED SUBBASE	CONCRETE CURB	PAVEMENT REMOVAL					UNDERDRAIN GROUP "K"	3ATE ERDF	DRAIN	<u>0</u>
CHL	668	NC.P.	MEN	STAB	CURE	PAVE		rype"p" comp. Agg. Base	BITUM.	CONCRETE	DERI GROU	GREC	DER	
ONS	TONS	υ μο <u>-</u> μο <u>-</u> χο 	BYS.	SYS.	LFT.	SYS.) M	70400 ⊢	ធិ	õS	LFT.			
103	10103	<u> </u>	213.	<u> </u>		515.							LFT	
	ſ													August 1
				2 2 1										
				<u> </u>			i.							
	· · · · · · · · · · · · · · · · · · ·								· · · · · · · · · · · · · · · · · · ·			5		
(*	
	· · · · · · · · · · · · · · · · · · ·										-	•		
								Ŷ						
						742								
					270									
	-								•					
											2100	200	120	
									· · · · · · · · · · · · · · · · · · ·				1	
					270						2100		120))
						742								
											1	200		
	¢								·····					
													Ť,	
							· · · · ·					· •		
			2					2						······································
								*						
														1. S.
				· · · · · · · · · · · · · · · · · · ·										
					· · · · · · · · · · · · · · · · · · ·									
				•				· · · · · · · · · · · · ·						
												(
				· · · · · · · · · · · · · · · · · · ·										
								PRO	JECT NO.	LINE	SHEET	TOTAL	FILE	
								£	- 875 (A		7	NO .		

	STRUCTURE NUMBER	LOCATION	LEFT	RIGHT	CROSS		GROUP	DESCRIPTION SEE ST'D. SHEET "MP" FOR ACCEPTABLE TYPE OF PIPE WITHIN EACH GROUP.	LENGTH	SKEW	COVER	FLOW d J J S ELEV.	DOWN STREAM	CONCRETE CONCRETE CLASS "A"	MONANOE Bandaros CO.ADS.	METHOD OF BACKFILL
	1	13+00 Line "A				123 X 81		No Change Req'd								
	2	0+82				12		No Change Req'd								
	3	4+10		1		15	D		24'							
						15	D		24'							B
	4	5+12		V												A
• •	5	8+80	-		✓ [−]	30	A		70'			••-				
		51+00 "S-2-A"			 ✓ ✓ 	24	<u>A</u>	<u>مەرىم مىرىمىيە ، 1 مەرىخ بالارد ، يارىمىيە ، 1 مەرىخا ، يارىمىيە ، 1 مەرىخا ، يارىمىيە ، 1 مەرىخا ، يارىمىيە ،</u>	100'	•		· · · · · · · · · · · · · · · · · · ·				A (
, V	7	12+40				15	<u>,</u> D	ATT THE PLANT	32'	-						B
	8	54+00 "S-2-Å	 Image: A state of the state of			12										
	9	58+70 "S-2-A		· /		12		No Change Req'd								
	10	6I+57 "S-Z-A"			<	8'XIO'		No Change Req'd								
							,									
								n - Sin and a star							1	
								30 11 illi solo	· · · · · · · · · · · · · · · · · · ·						,	
						5 										
							-									
	•						s									
2																
•																
					·			and a second	هين ۽ ا			·				
				-				and the backs		-					1 1 1 1 1 1 1 1 1 1 1 1 1 1 1 1 1 1 1	
											: .				Att 1	
							, ,									
• • •																
•																
		· · · · · · · · · · · · · · · · · · ·												2		
r.																
A State of the second s												•				
•																
	L							A TT ALLAND								
				-		4- -	-	1.5° 1			. : . :	·····				

•

	NESS			9z		STRUCT									DESCRIPTION	Т
	HES * WN PI	VELOCITY			BEINF.	REMARKS	PLANS ON SHEET NO.	STRUCTUF NUMBER		LEFT	RIGHT	CROSS	JZI S INCHES	GROUP	SEE STD SHEET "MP" FOR ACCEPTABLE TYPE OF PIPE WITHIN EACH GROUP.	LENGTH
						Existing Structural Plate Pipe Arch	5									
							5									
2	0.105			-2		Remove Pipe in Place	5									
7	0.105			2		Remove Pipe in Place	5									
4	-			1		Connect to Existing Pipe	5							•		
7				2		Construct Outlet Ditch	5		· · · · · · · · · · · · · · · · · · ·							
	0.105		·	2			5									
-		· · · ·		<u>, , , , , , , , , , , , , , , , , , , </u>	· · · ·	Remove Pipe in Place	5									
							5									
						Existing Box Culvert	5									
															· · · · · · · · · · · · · · · · · · ·	
									-		·					
															· · · · · · · · · · · · · · · · · · ·	
-																
-																
													-			-
			<u> </u>		•											
	· ·				-											
									·			1	· · · ·		· · · · · · · · · · · · · · · · · · ·	
the second se																
					<u> </u>	······································					_					
╞																
							· · · · · · · ·									
										6.5		1			COATED CORRUGATED STE	
										3.1.1.1.				S. K. Sel	COATED CORRUGATED ALL COATED CORRUGATED STE	
									C. S		C	ORRI	JGATED S	TEE		
					<u> </u>				C. A. A S. P. S							
		1	1 .	1	· ·]]								

NOVEMBER 1972



, ?

t	r	·	·	OWN BELC				<u>e ne</u>	1	1	5		IND.	ST-875(A)	8	
	COVER	FLOW BLOW	DOWN STREAM	CONCRETE, CLASS "A"	BORROW	METHOD OF BACKFILL	GAGE THICK 米 급	NESS WINTY	VELOCITY	RIPRAP	PIPE END SECTION	REINF. STEEL		REMARKS		PLANS ON SHFFT NO
	Ĭ	တ ELEV.	ELEV.	CU. YDS.	CU.YDS.	س چ م	STEEL	ALU	VEL	SYS.	EA.					Ч. Ч.
	-															
+		······································		· · · ·												
+																
╉						· · · · · · · · · · · · · · · · · · ·						<u>(</u>				
_		•												· · · · · · · · · · · · · · · · · · ·		
_				· · · · · · · · · · · · · · · · · · ·					•							
-			<u>.</u>							• •						
					 		-									
	<u>- 1000</u> - 1000						9 20 30 20 21 20 30 20 20									
7	•															
	· .															
				×												
-													_			
														3		
. `	· · · ·															
													· · · ·		• •	
														· · · · · · · · · · · · · · · · · · ·		
															< r	
						× .										
													1			
										1						

F.B. C. C. A.A. A. ---- FULLY BITUMINOUS COATED CORRUGATED ALUMINUM ALLOY ARCH:

*

C.S.A. ----- CORRUGATED STEEL ARCH.

C.A. A.A. ----- CORRUGATED ALUMINUM ALLOY ARCH.

S.P. S.A. ------ STRUCTURAL PLATE STEEL ARCH.

		PROJE	ECT NO. LINE	SHEET TOTAL NO SHEET	FILE
